

LYLE A. & VERA B. KNIGHT


SEC. 24, T. 11 S., R. 2 W., WM., LINN CO., ORE.

Scale: 1" = 10 Chains

Dec. 4, 1957

ORRIS A. CARNEGIE
DEP. CO. SURVEYOR

I, Orris A. Carnegie of Albany, Oregon do hereby certify that this map was made from notes taken during an actual survey made by me on December 4, 1957 and supplemented by information taken from the latest aerial photographs; that the monument shown on this map consisting of a 3/4" iron rod is N.46°35'W. 59.09 chains from the Southeast corner of section 24, T. 11 S., R. 2 W. of the Will. M. in Linn County, Oregon.

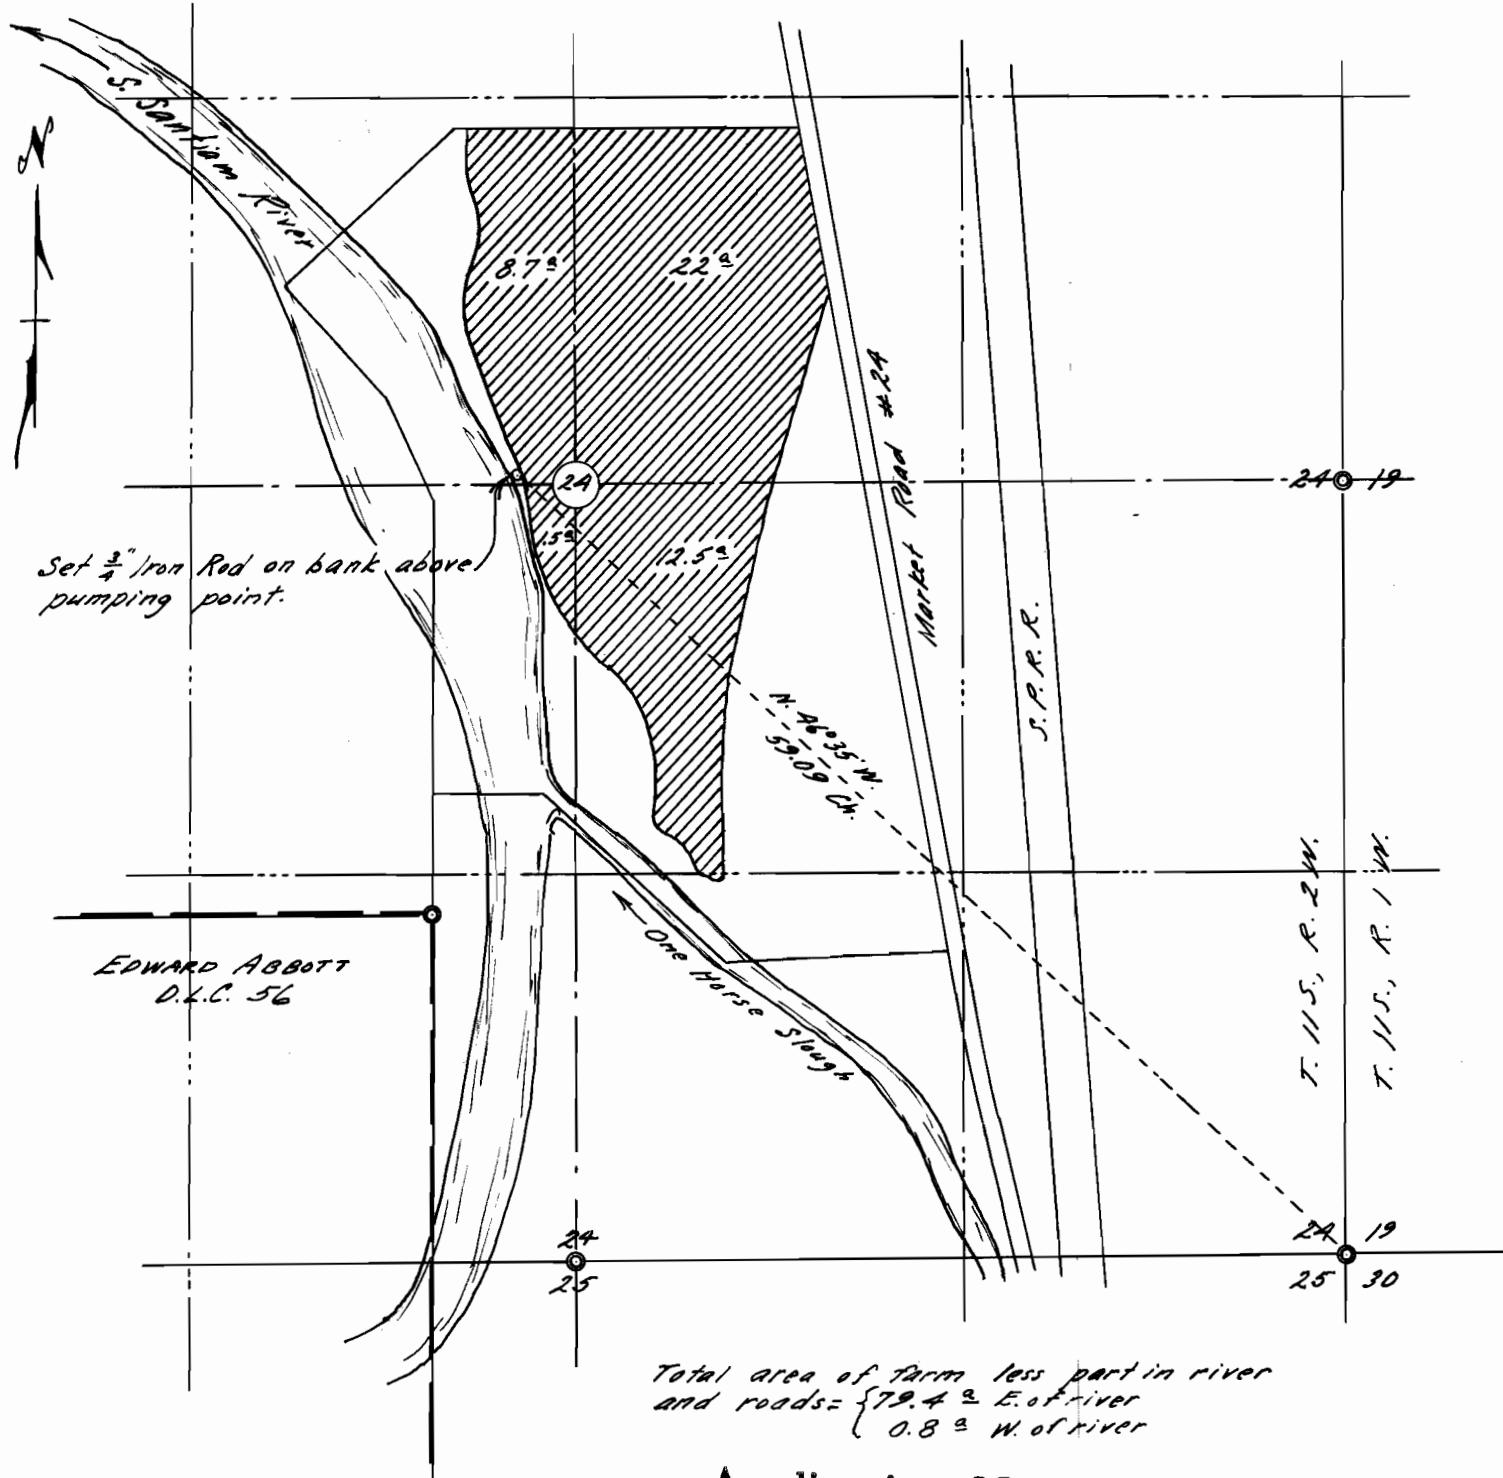

Application No. 32018
Permit No. 25258