


36-4-24-2

T. 36 S. R. 6 W. M.

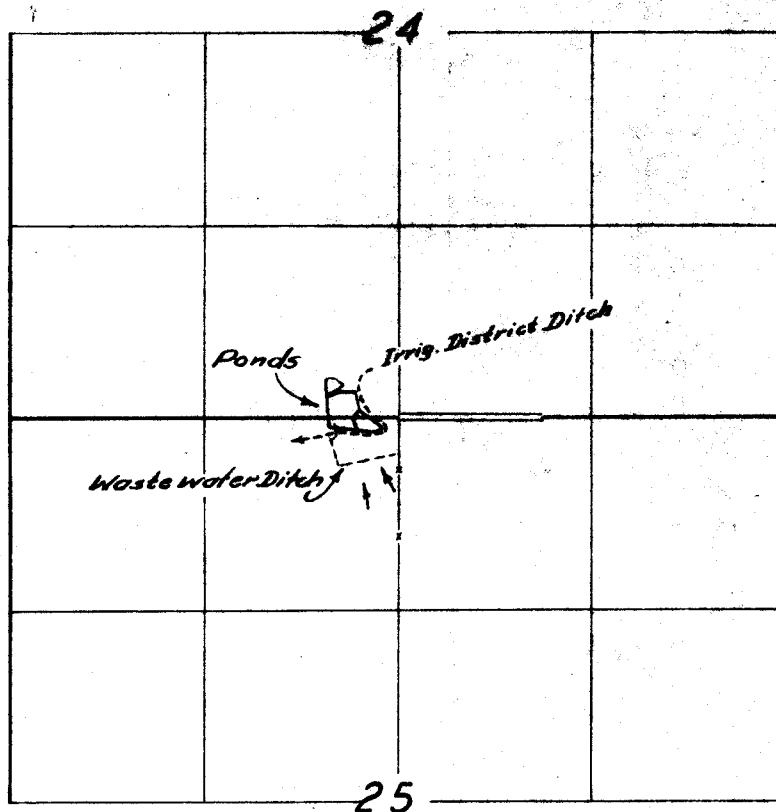

FINAL PROOF SURVEY

UNDER

R-31997

R-2108

32024 Permit No. 25287

IN NAME OF

FRANK SCHUTZWHL

Survey, July 15, 19 59 by C.O. Bartels

1959-4