


T. 36 S. R. 6 W. W. M.

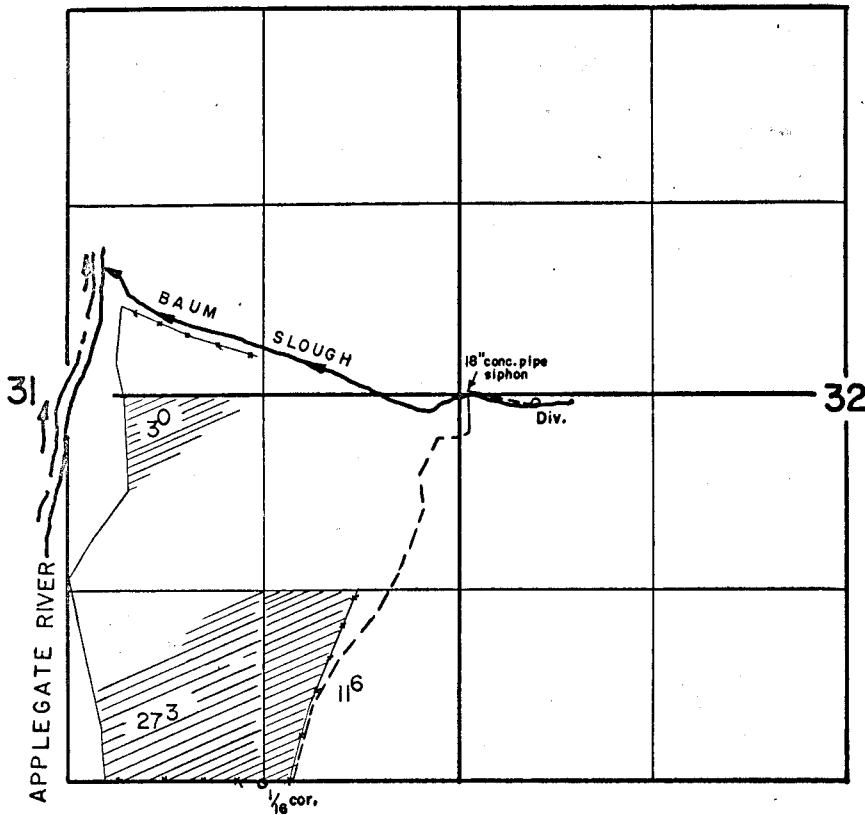

FINAL PROOF SURVEY
UNDER

Application No. 32186... Permit No. 25390...
IN NAME OF

.....WM. F. SPRATLING.....

Surveyed March 11, 1965, by R. B. Steimer....