


TWP 39 S R 0 W W M

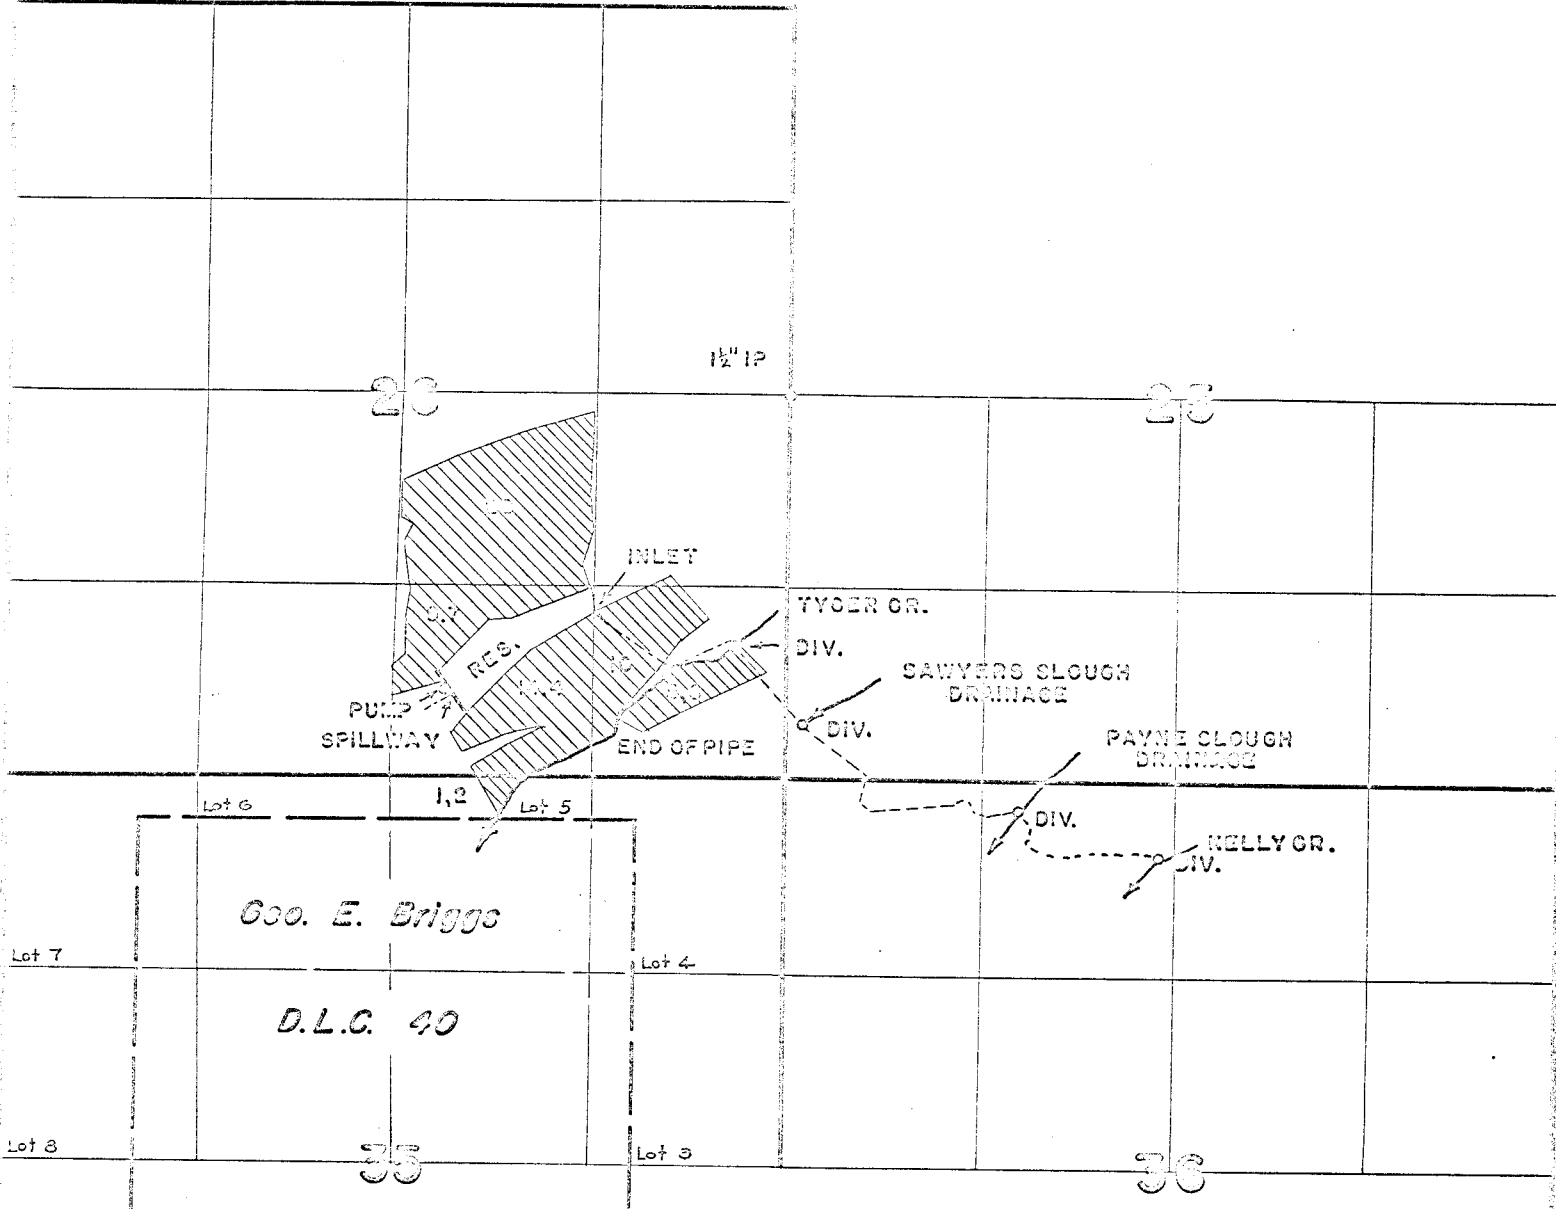

FINAL PROOF OF SURVEY UNDER

R-30320 R-2118  
Application No. 30321 Permit No. 25404  
IN NAME OF

.....Edith L. Sowell.....

Surveyed 6-13 1962, by R. Steimer.....