


Sec. 1
T37S, R15W, W.M.

Descriptive Map
SW 1/4 of Sec. 6 T37S, R14W, W.M.

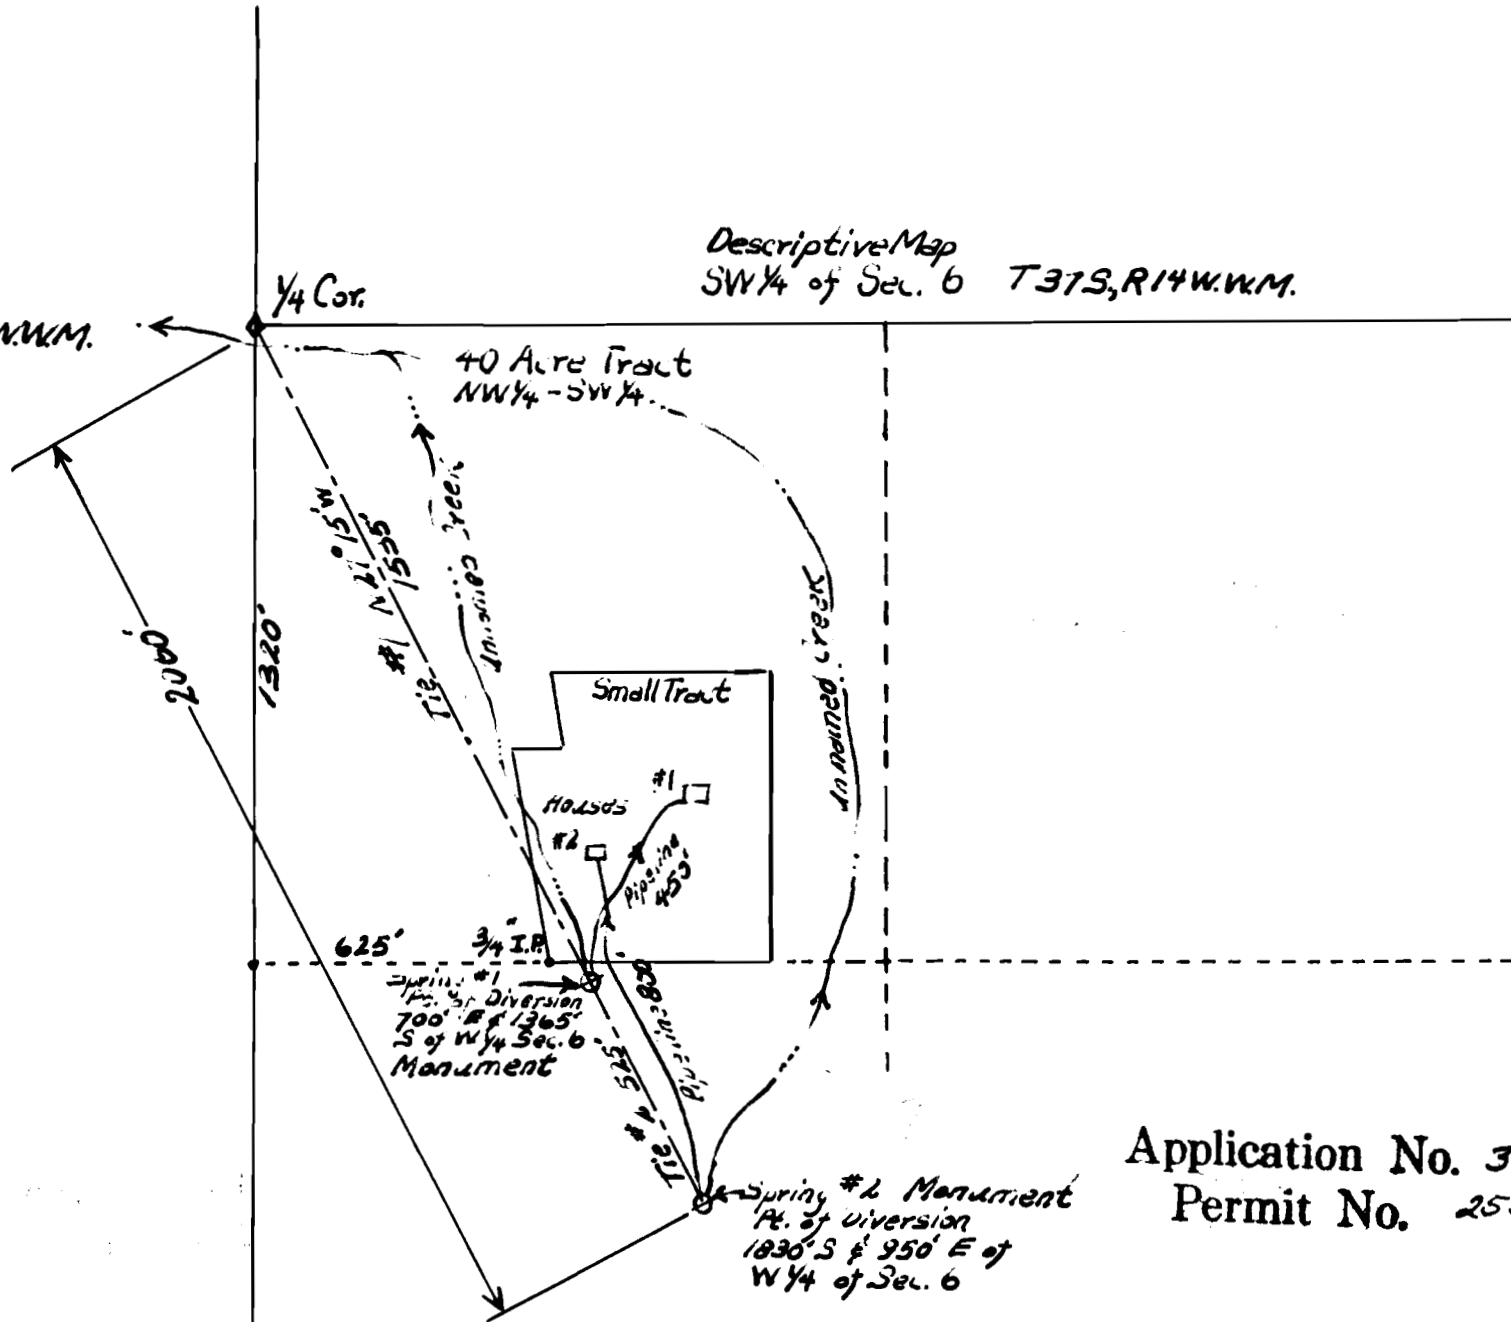

Application No. 32314
Permit No. 25503