

SEE MAP # 55 + 62

Guy O. Nelson
Application No. 32331
Permit No. 25509

P. 25509


Map to accompany application in the name of Guy O. Nelson, for a permit to appropriate water from Rogue River for Supplemental Irrigation purposes.

This Office --- May 11, 1958.

David C. Hendrix, Watermaster



Scale: 8 inches = 1 mile.

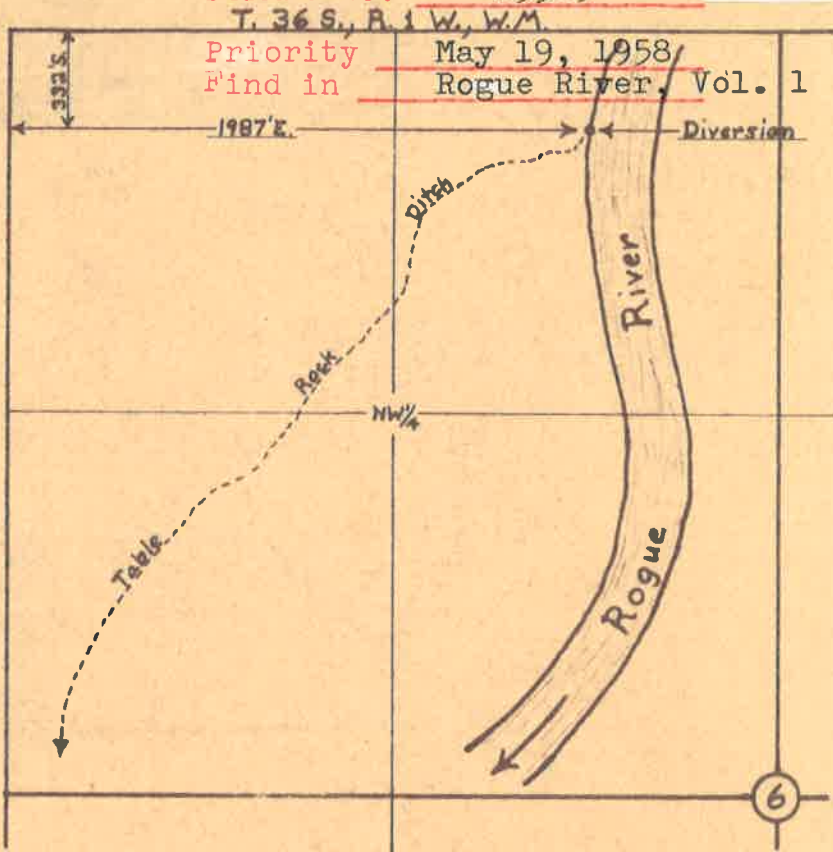

CENT. 32438

