

S.W. 1/4 NE. 1/4


S.E. 1/4 NE. 1/4

25
Fd.
I.P.

25 30
Fd. 1/4 Cor.
I.P.

N.W. 1/4 S.E. 1/4

N.E. 1/4 S.E. 1/4

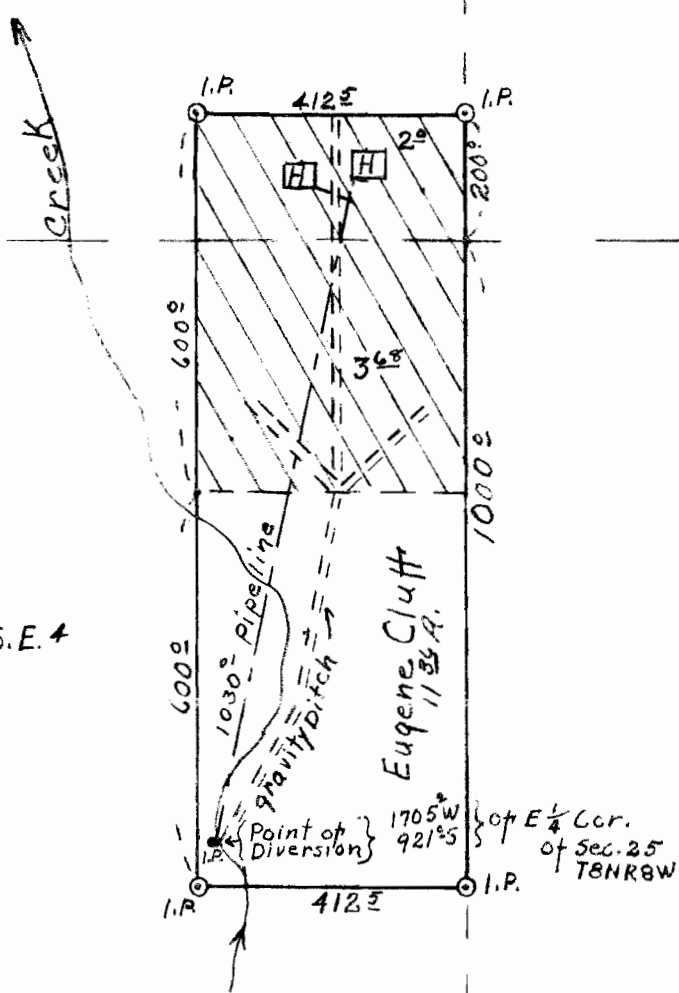

SURVEY
for
Eugene Cluff
Sec. 25 T8NR8W.W.M.
Clatsop County



Scale 1"=300' 7/20/58

REGISTERED
OREGON
LAND SURVEYOR
Arne E. Jarvi
ARNE E. JARVI
244

Application No. 32356
Permit No. 25552

T8NR8W

25 30
36 31
Fd. I.P.

25
36