


6S 2W

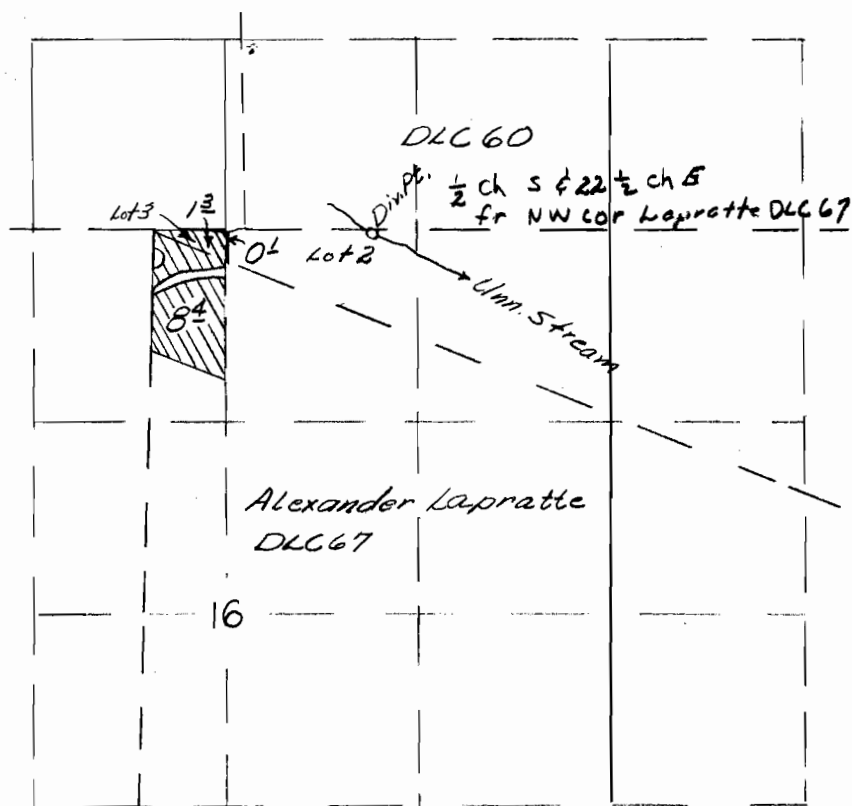

Ernest Reding

Land shown on FP with Pers 20524 & 22399

Application No. 32432
Permit No. 25603