


POINT OF DIVERSION

1" IP MON.
 S. 182 ⁵⁵/₈₈ from
 W. 1748 ²⁸/₈₈
 21/22 T.3S.
 28/27 R.9W

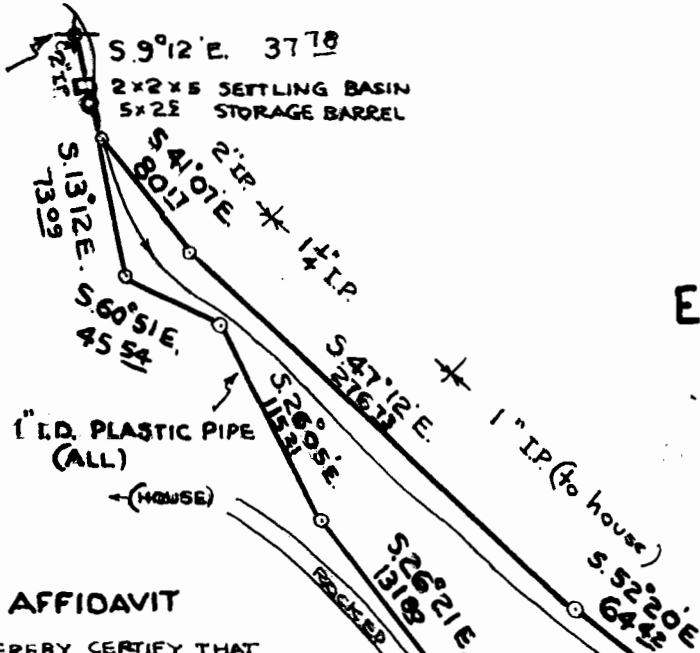

SURVEY MAP
 FOR
EDWARD D. EGGER
JOE AUTRY
WATER RIGHT
 IN
NE 4 SECTION 28
T. 3 S. R. 8 W., W.M.
 TILLAMOOK COUNTY, ORE.
 SEPT. 1958
SCALE 1"=100'

SURVEYORS AFFIDAVIT

I, JOHN L CARLICH HEREBY CERTIFY THAT THIS MAP WAS MADE FROM NOTES OF AN ACTUAL SURVEY MADE BY ME IN AUGUST, 1958; THAT THE MONUMENT, CONSISTING OF A 1" IRON PIPE, 48" LONG, IS SOUTH 182 ⁵⁵/₈₈ FEET AND WEST 1748 ²⁸/₈₈ FEET FROM NORTHEAST CORNER OF SEC. 28, T3S, R9W, W.M.

REGISTERED
OREGON
 LAND SURVEYOR
John L. Carlisch
 MAY 9, 1952
 JOHN L. CARLICH
 287

EDWARD D EGGER RES.

JOE AUTRY RES.

← **BIG NESTUCCA RIVER** Application No. 32108
 Permit No. 25662

