J. R. Williamson Estate

Water Right Survey in Section's 19 & 30 T. 12 S.R. 4 W. of the Will. Mer.

I J.W. Hanna Lic. Surveyor do hereby Certify that this map was made from notes taken during an actual survey, from County Survey Record No. 224 and from Acrial maps.

Well # 1 is South 682.28 ft & East 3286.30 ft. from the N.W. Corner of Section 30, T. 12 S R 4 W

" # 2 " " 290.75 " & " 3824.20 ft " " " " " " " " " " " "

Variable diversion along the Northeasterly Line of Vol. 70 page 541 Benton County Deed Records

" " " " South & East line of " 76 " 194 " " " "

" " from the N.E. Cor of Vol. 76 page 194 Northerly to the S.E. Cor of property described as an exception in Vol. 40 page 354

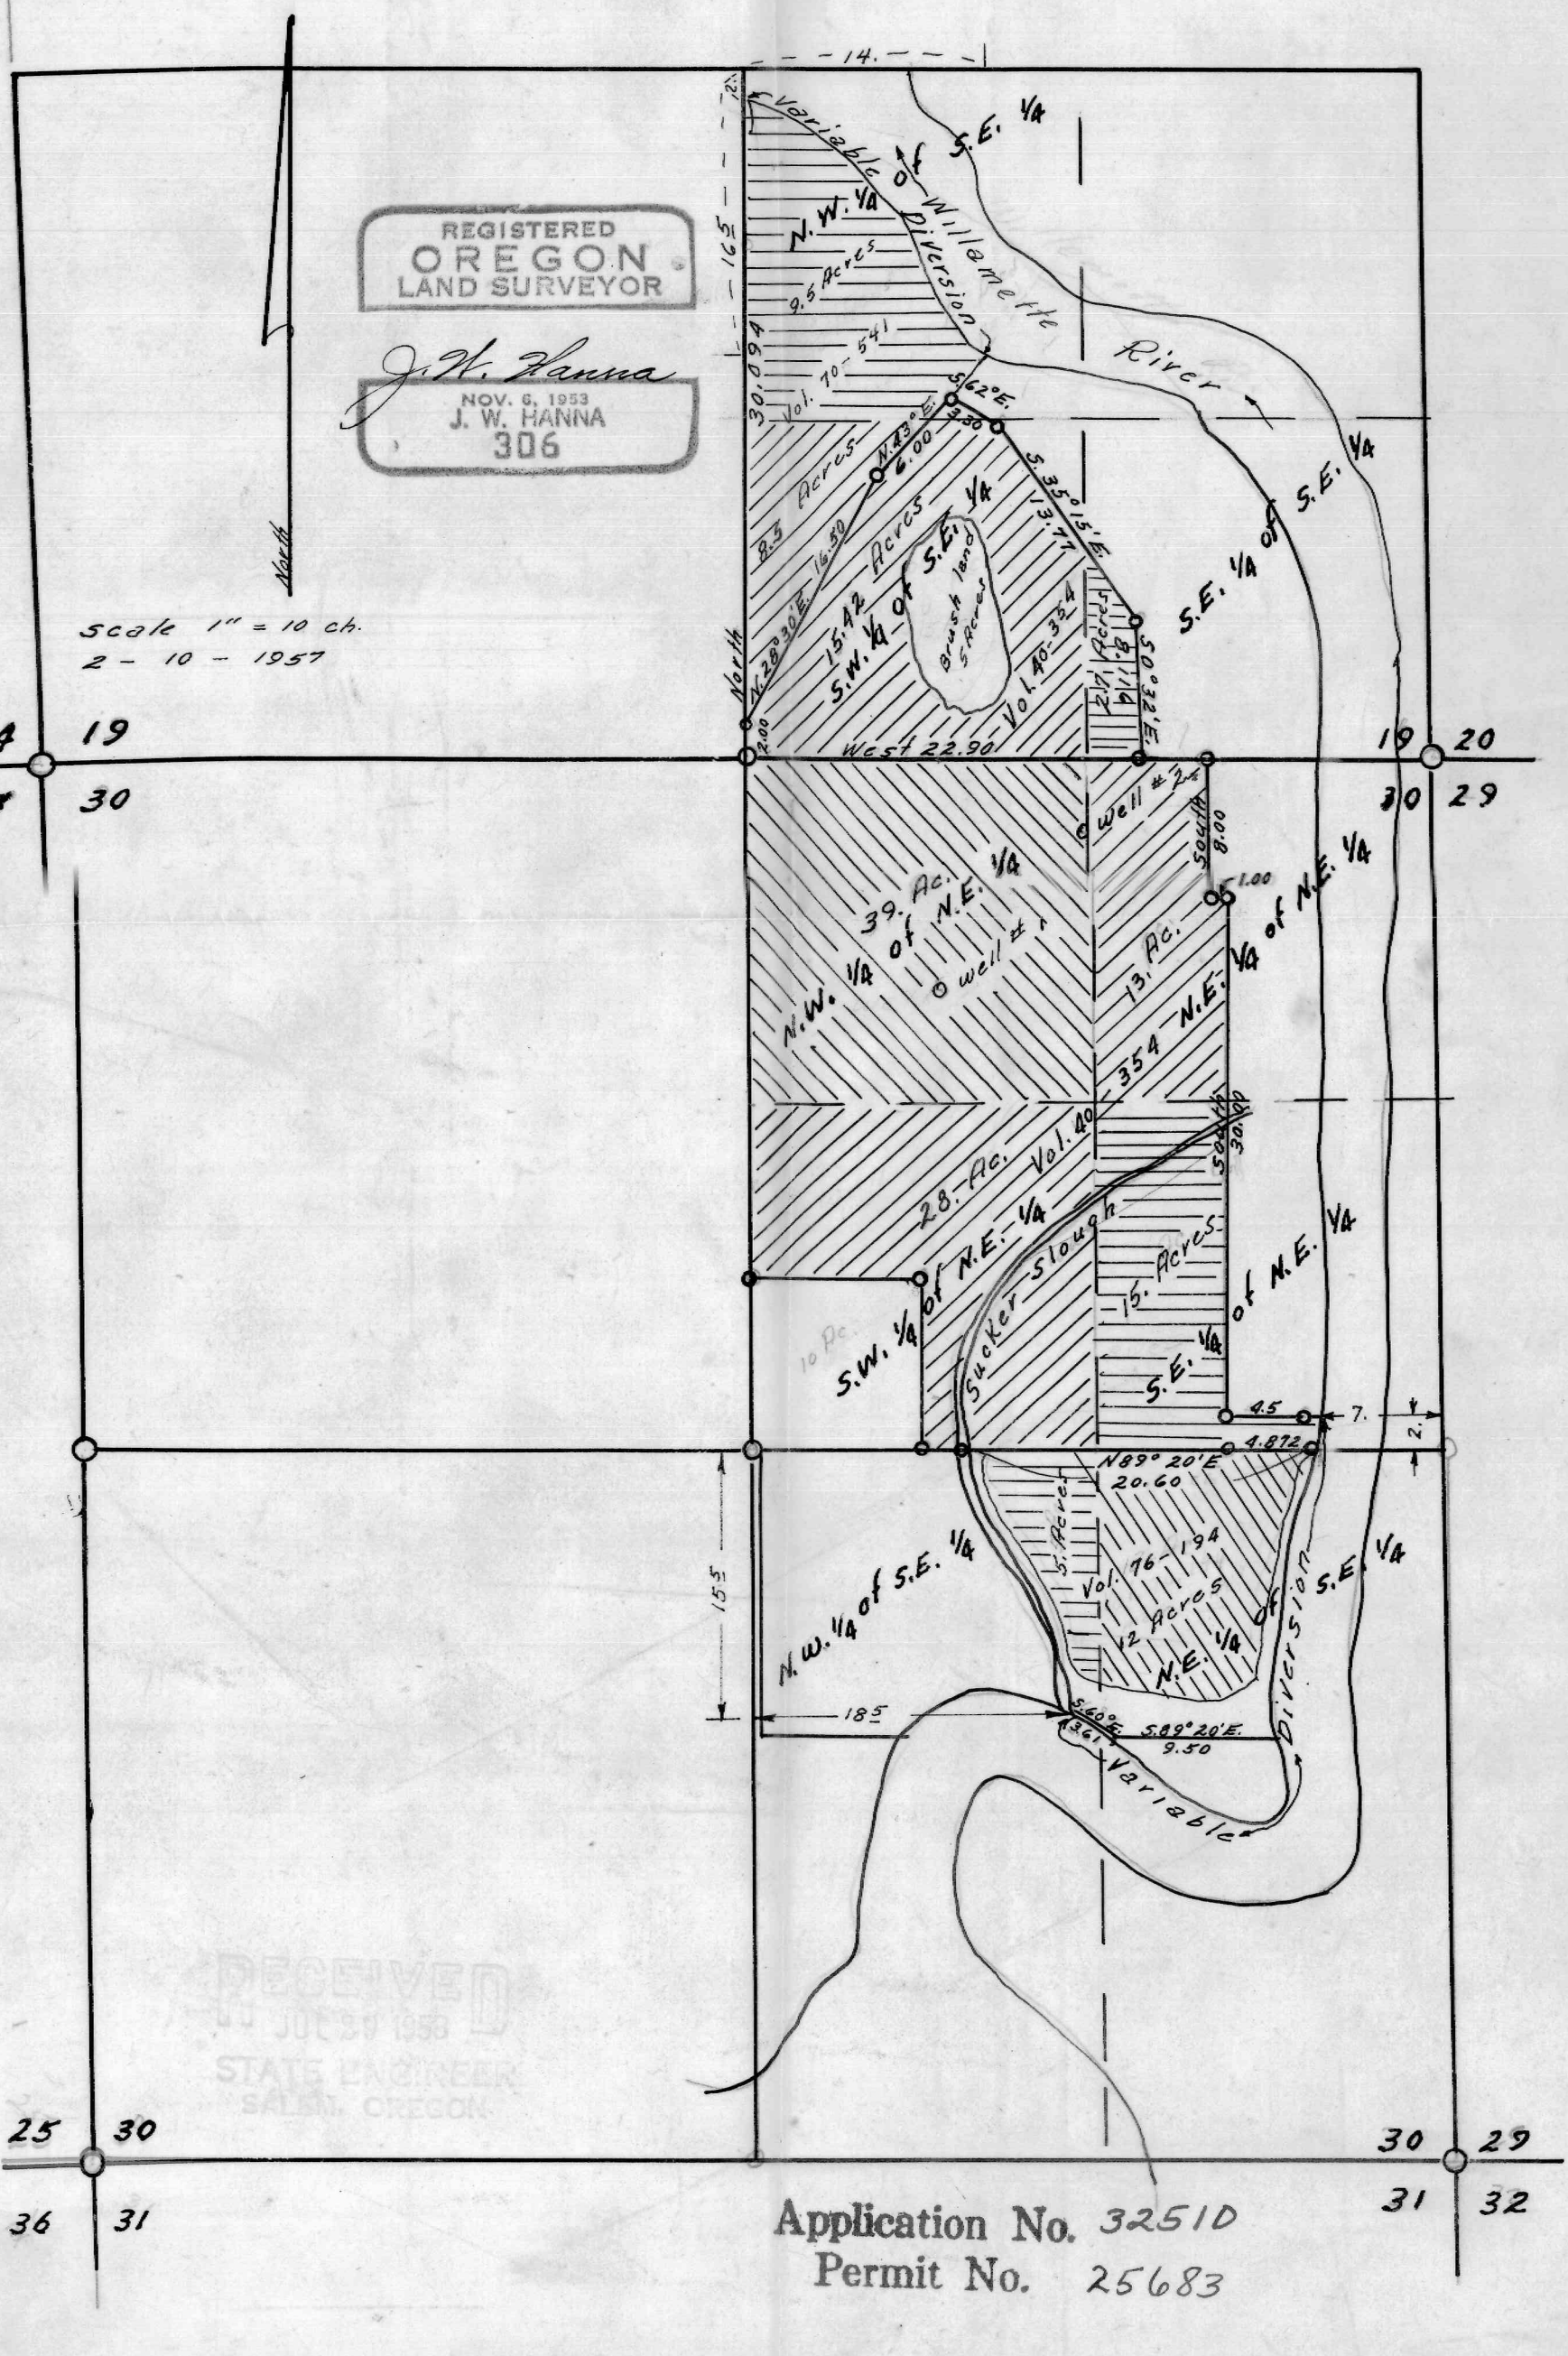

RECEIVED
JUL 29 1958
STATE ENGINEER
SALEM, OREGON

Application No. 32510
Permit No. 25683