


TWP 35 S R 6 W W M

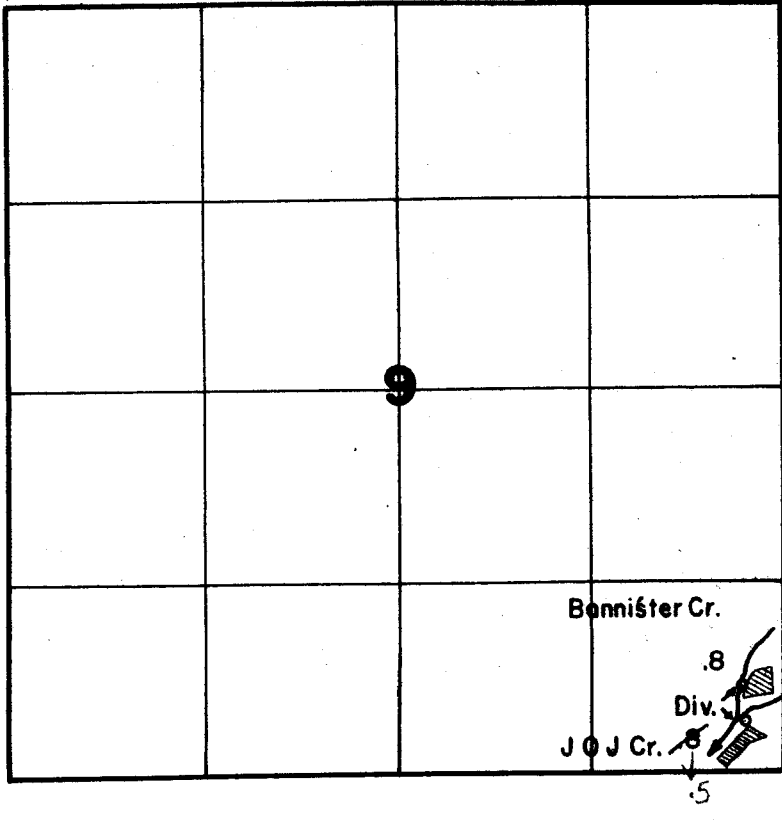

FINAL PROOF SURVEY UNDER

Application No. 32572 Permit No. 25712
IN NAME OF

Clarence W. Trotter

Surveyed 6-11 1962, by R. Steimer