


T.38S.R.16&17E.W.M.

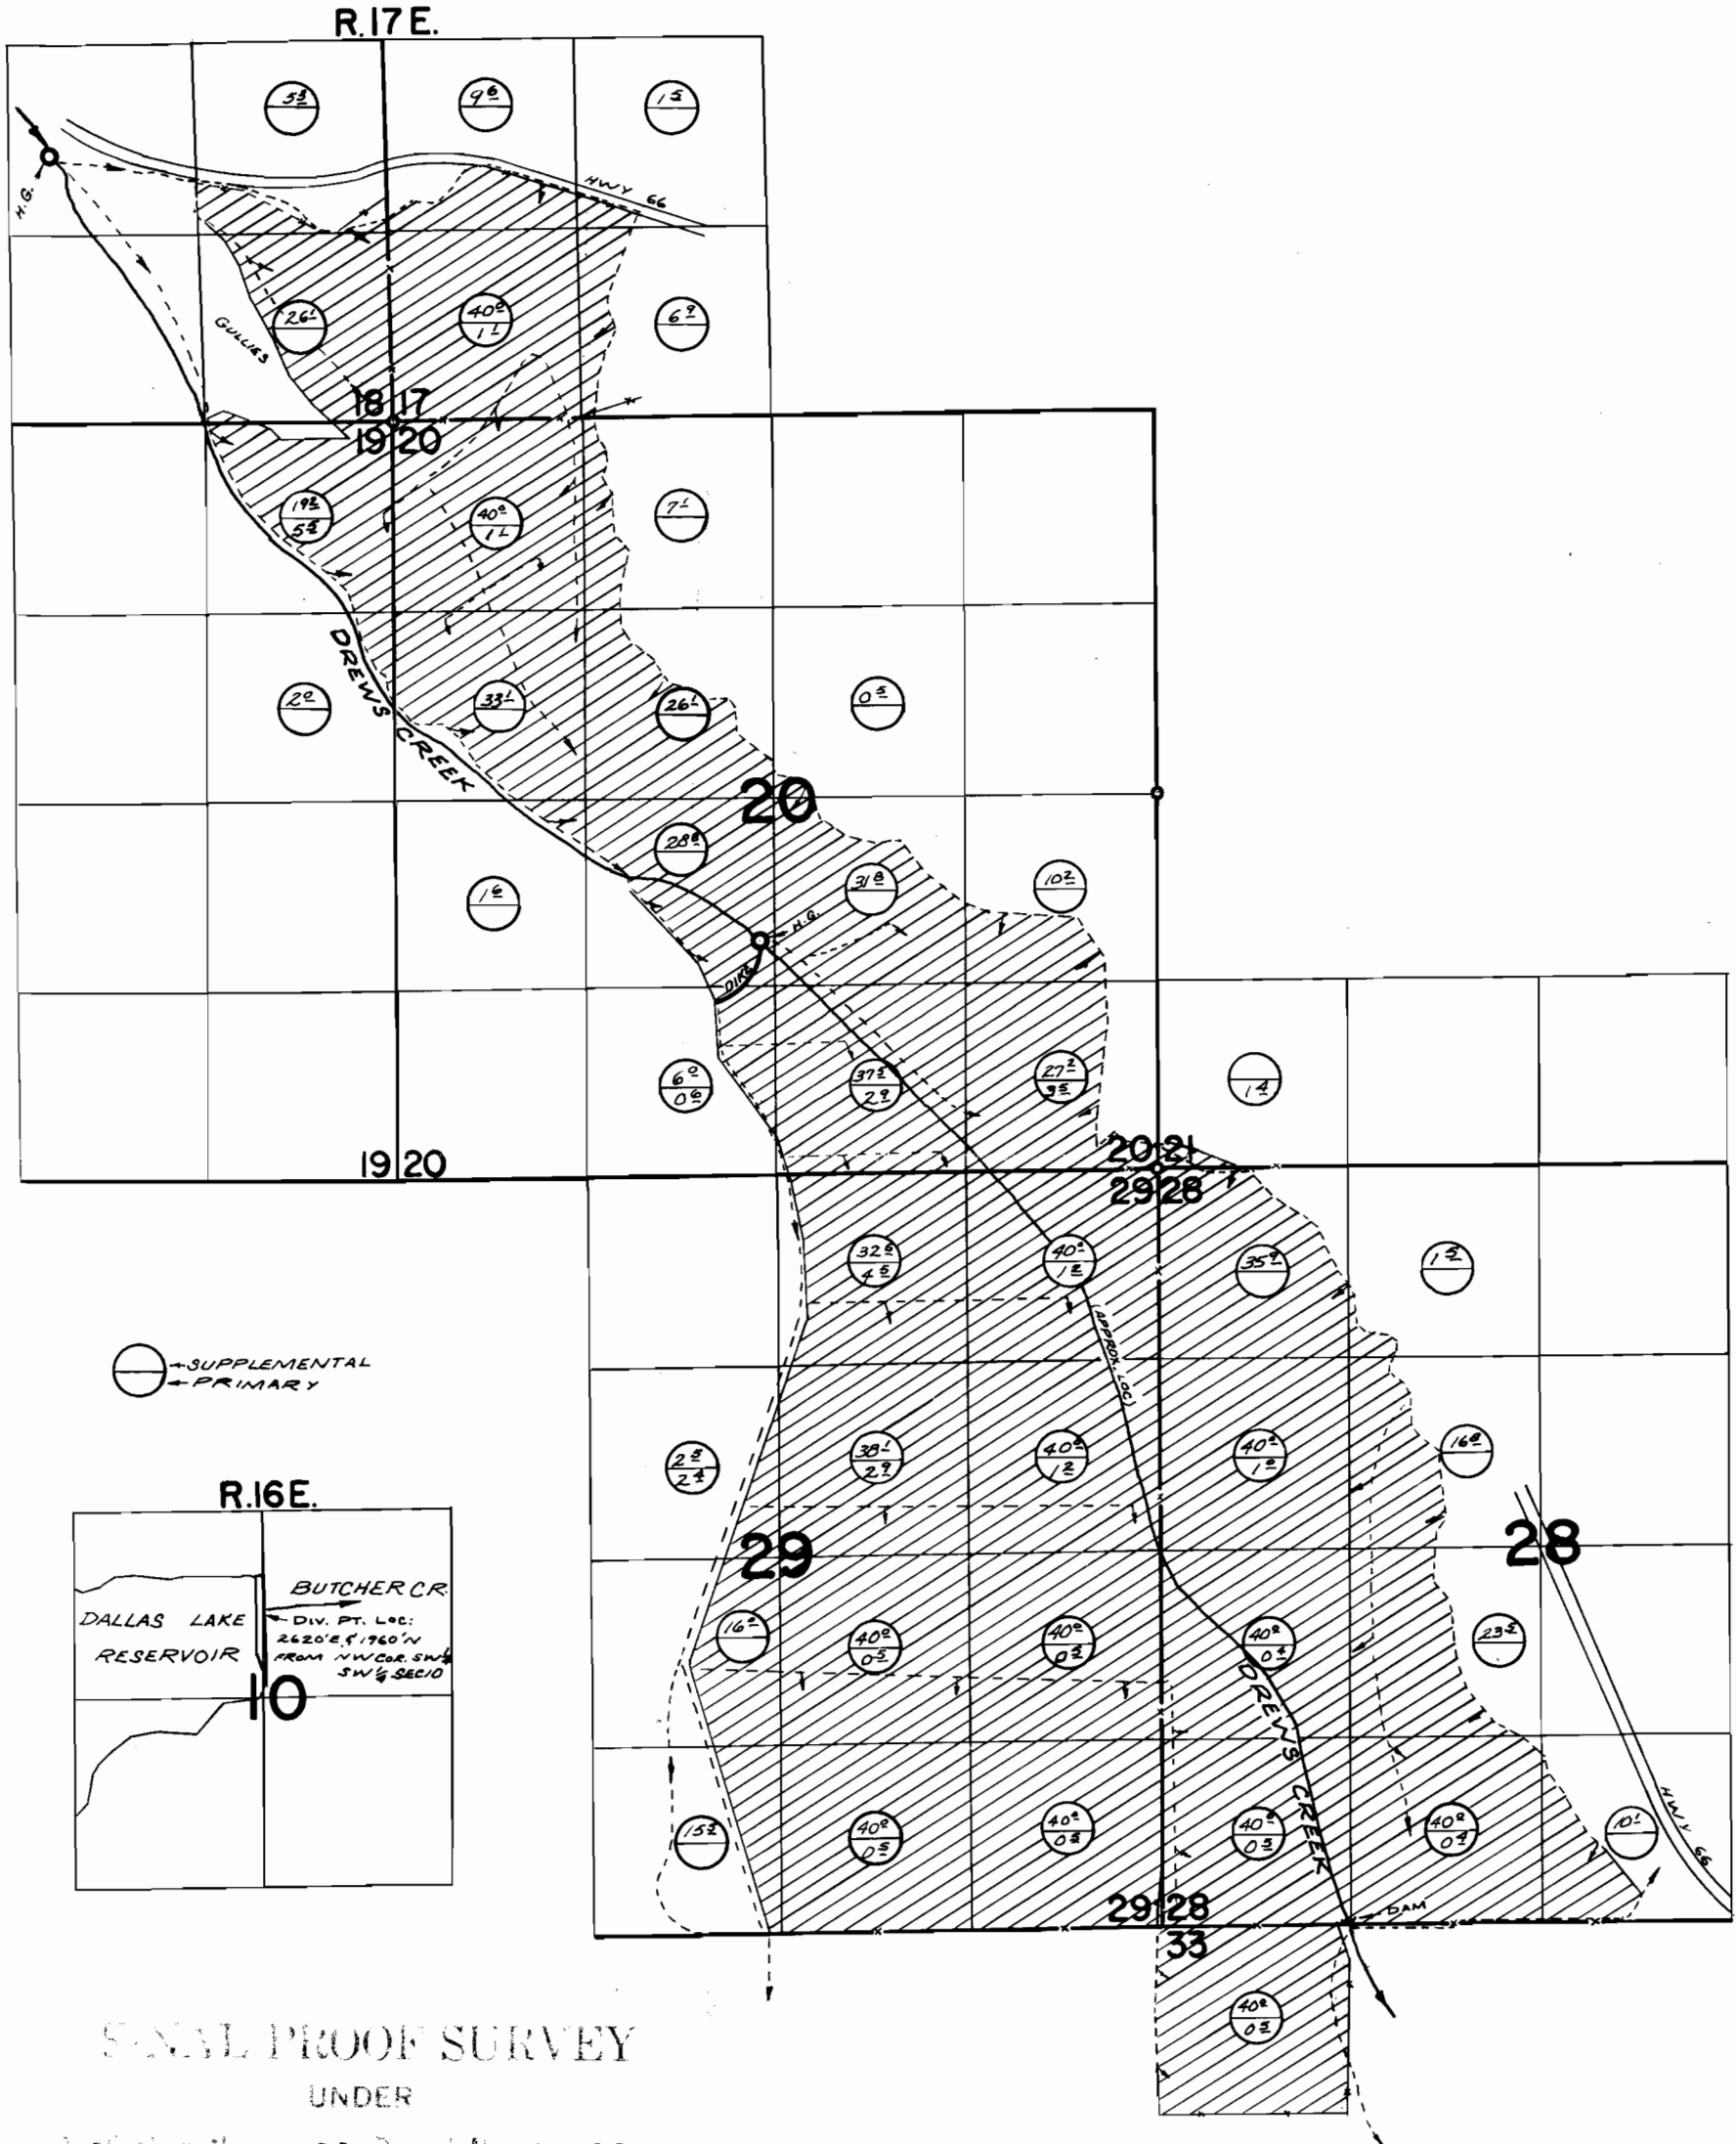

SUBV. PROOF SURVEY

UNDER

Authority of the 32630 Permit No. 25738

IN NAME OF

DREWS VALLEY RANCH

Surveyed AUG. 5-7, 1970, by R. MUCKEN

