


TWP 38 S R8 WWM

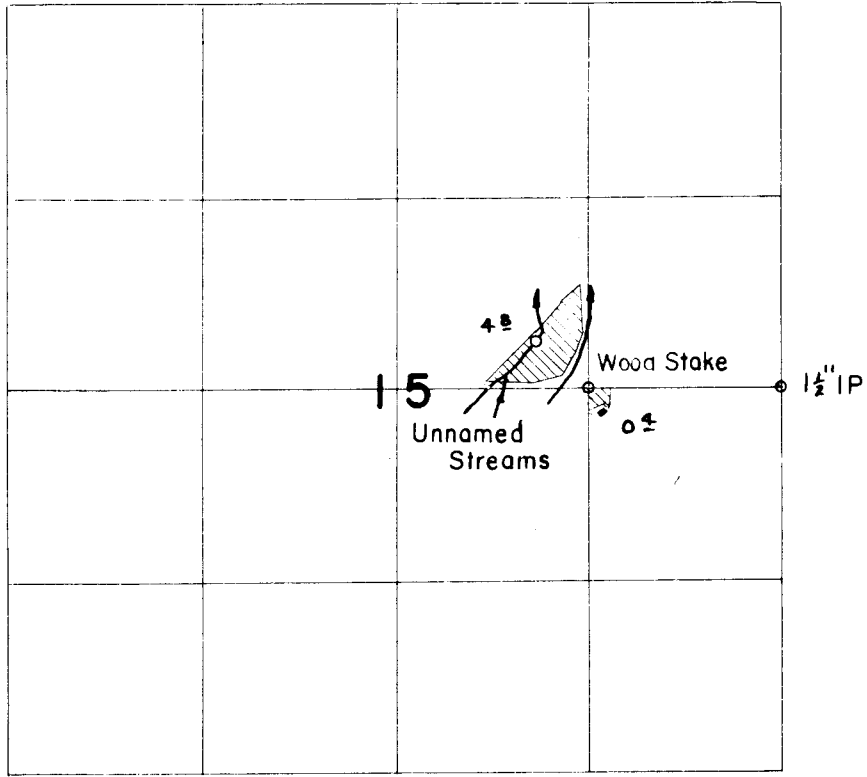

FINAL PROOF SURVEY
UNDER

Application No. 32712 Permit No. 25812
IN NAME OF

Robert J Lanfranco

Surveyed 6-1 1962, by R Steimer