


T. 1 S. R. 9 W. WM

scale 1" = 1320'

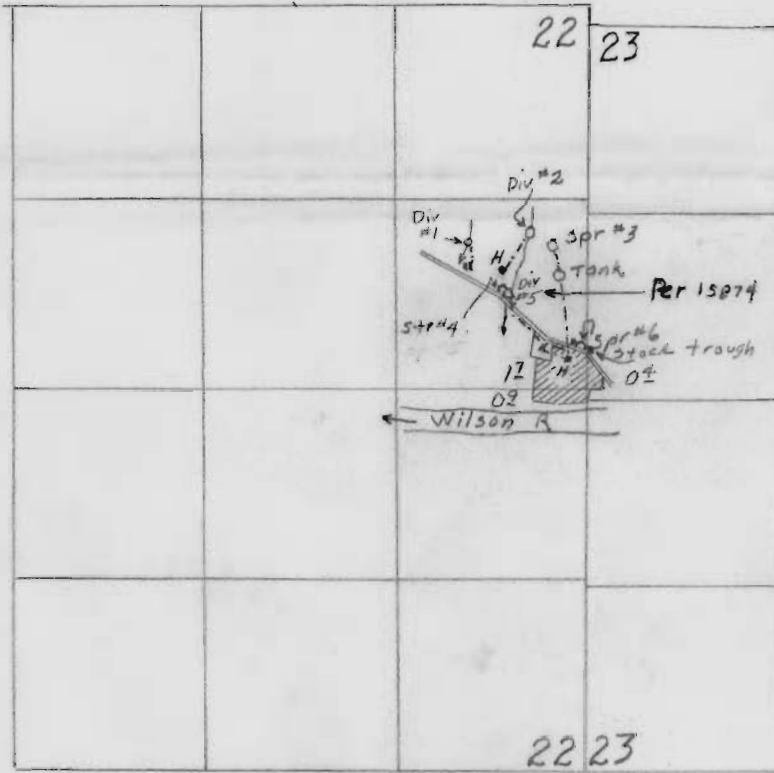

Div #1 1000' N @ 825' W  
Div #2 1060' N @ 375' W  
Div #3 950' N @ 240' W  
Div #4 675' N @ 580' W  
Div #6 280' N @ 40' W  
all from E 1/4 cor Sec 22

Traced from F.P. Survey Per 15874  
except for fire protection pond.

Application No. 32732  
Permit No. 25841