


T.33.N.5 W.11.E.

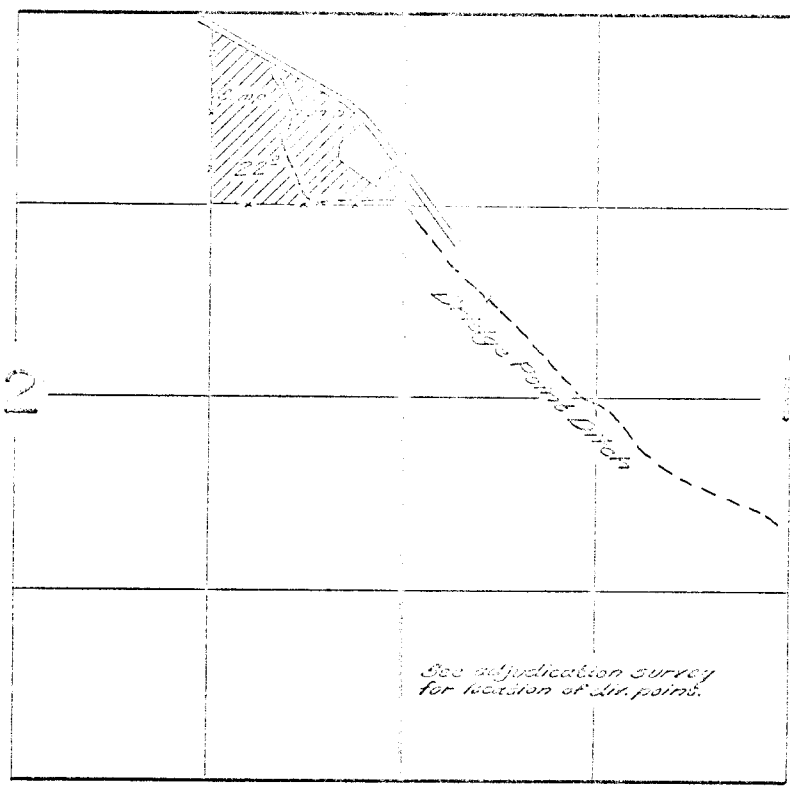

FINAL PROOF SURVEY
UNDER

Application No. 38285... Permit No. 28097...
IN NAME OF

.....M. B. ...

Surveyed May 15, 1909, by ...