


RECEIVED  
MAY 12 1964  
STATE ENGINEER  

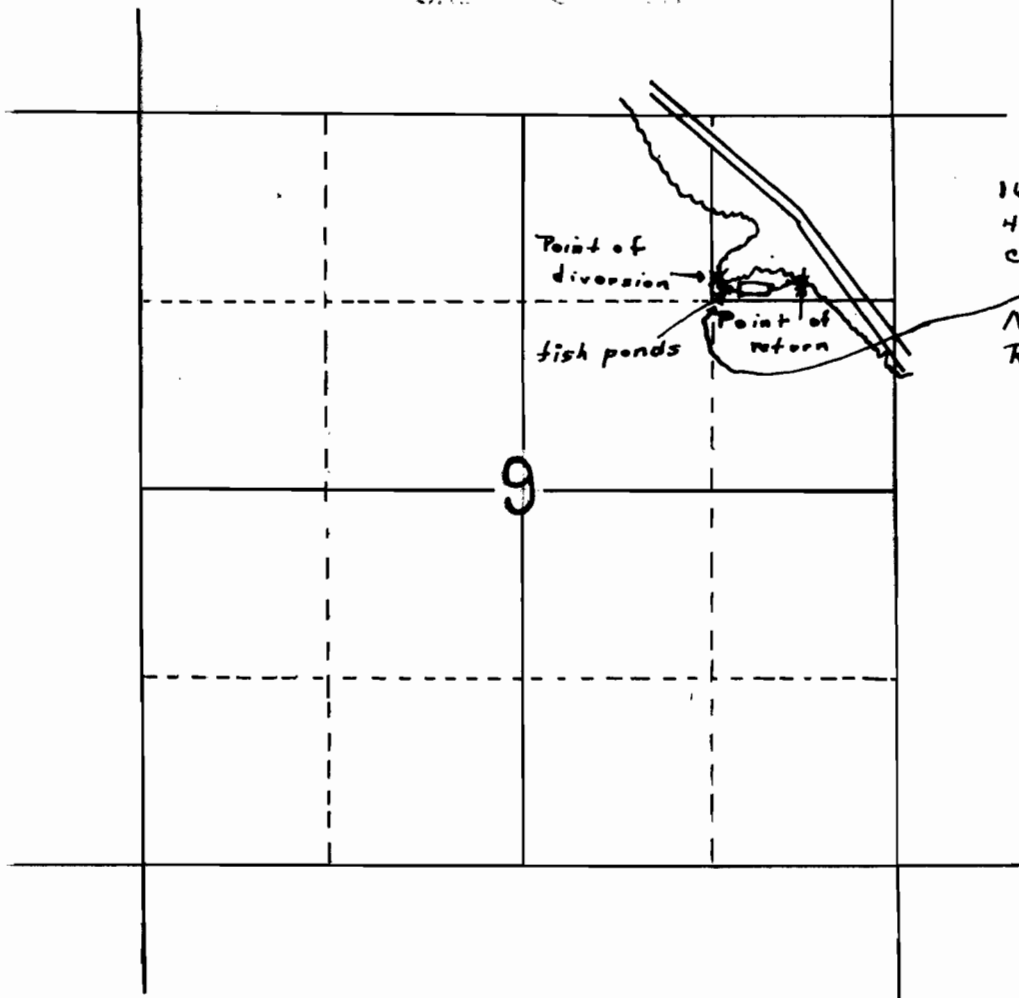

167 feet North and  
42 feet east of this  
corner. (the SW corner  
of the NE<sup>4</sup> of the  
NE<sup>4</sup> of Sec 9 T15  
R 4 W. W.M.)

Section 9 T15, R4W, W.M.

29453

Application No. 29453  
Permit No. 26045