


18 17
19 20

W 1/16 COR. 17 & 20



SCALE 1" = 200'
○ IRON PIPE
● IRON PIN

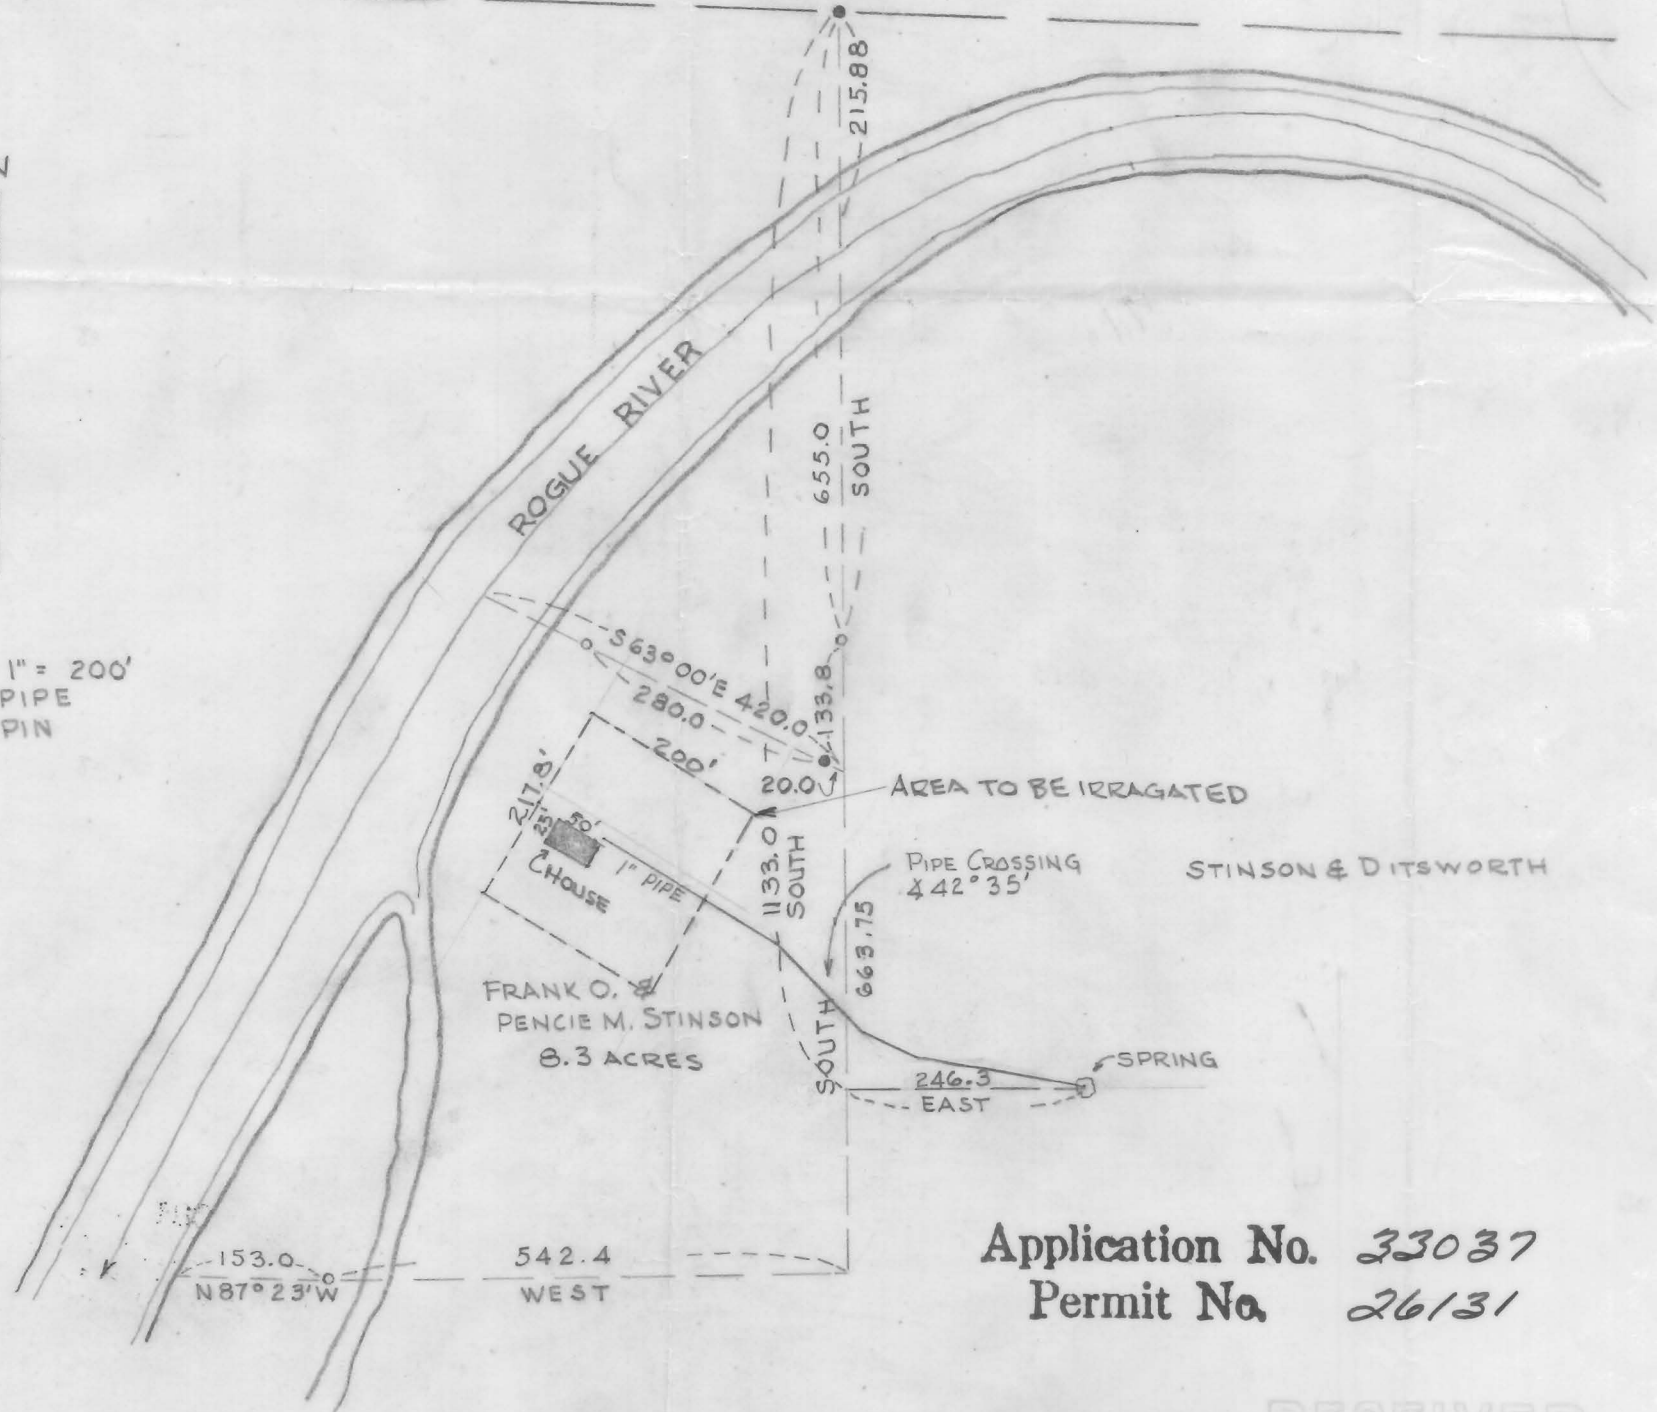

Application No. 33037
Permit No. 26131

STINSON & DITSWORTH
NW 1/4 SEC. 20. T. 33 S. R. 2 E.

RECEIVED
MAY 1 1959
STATE ENGINEER
SALEM, OREGON
RECEIVED
APR 10 1959
STATE ENGINEER
SALEM, OREGON

REV: ADDED HSE & BOUNDARIES OF THE ACRE 4/29/59