

Yost, H.C.


D. M. Russell
Cohoe

ERHART ACRES

Approved this 26th day of October 1914 by

Selma Thompson
R. H. Hemphill
See McLawley
Benjamin F. Keeney
Hollis Walby

County Judge
County Commissioner
County Commissioner
County Assessor
County Surveyor

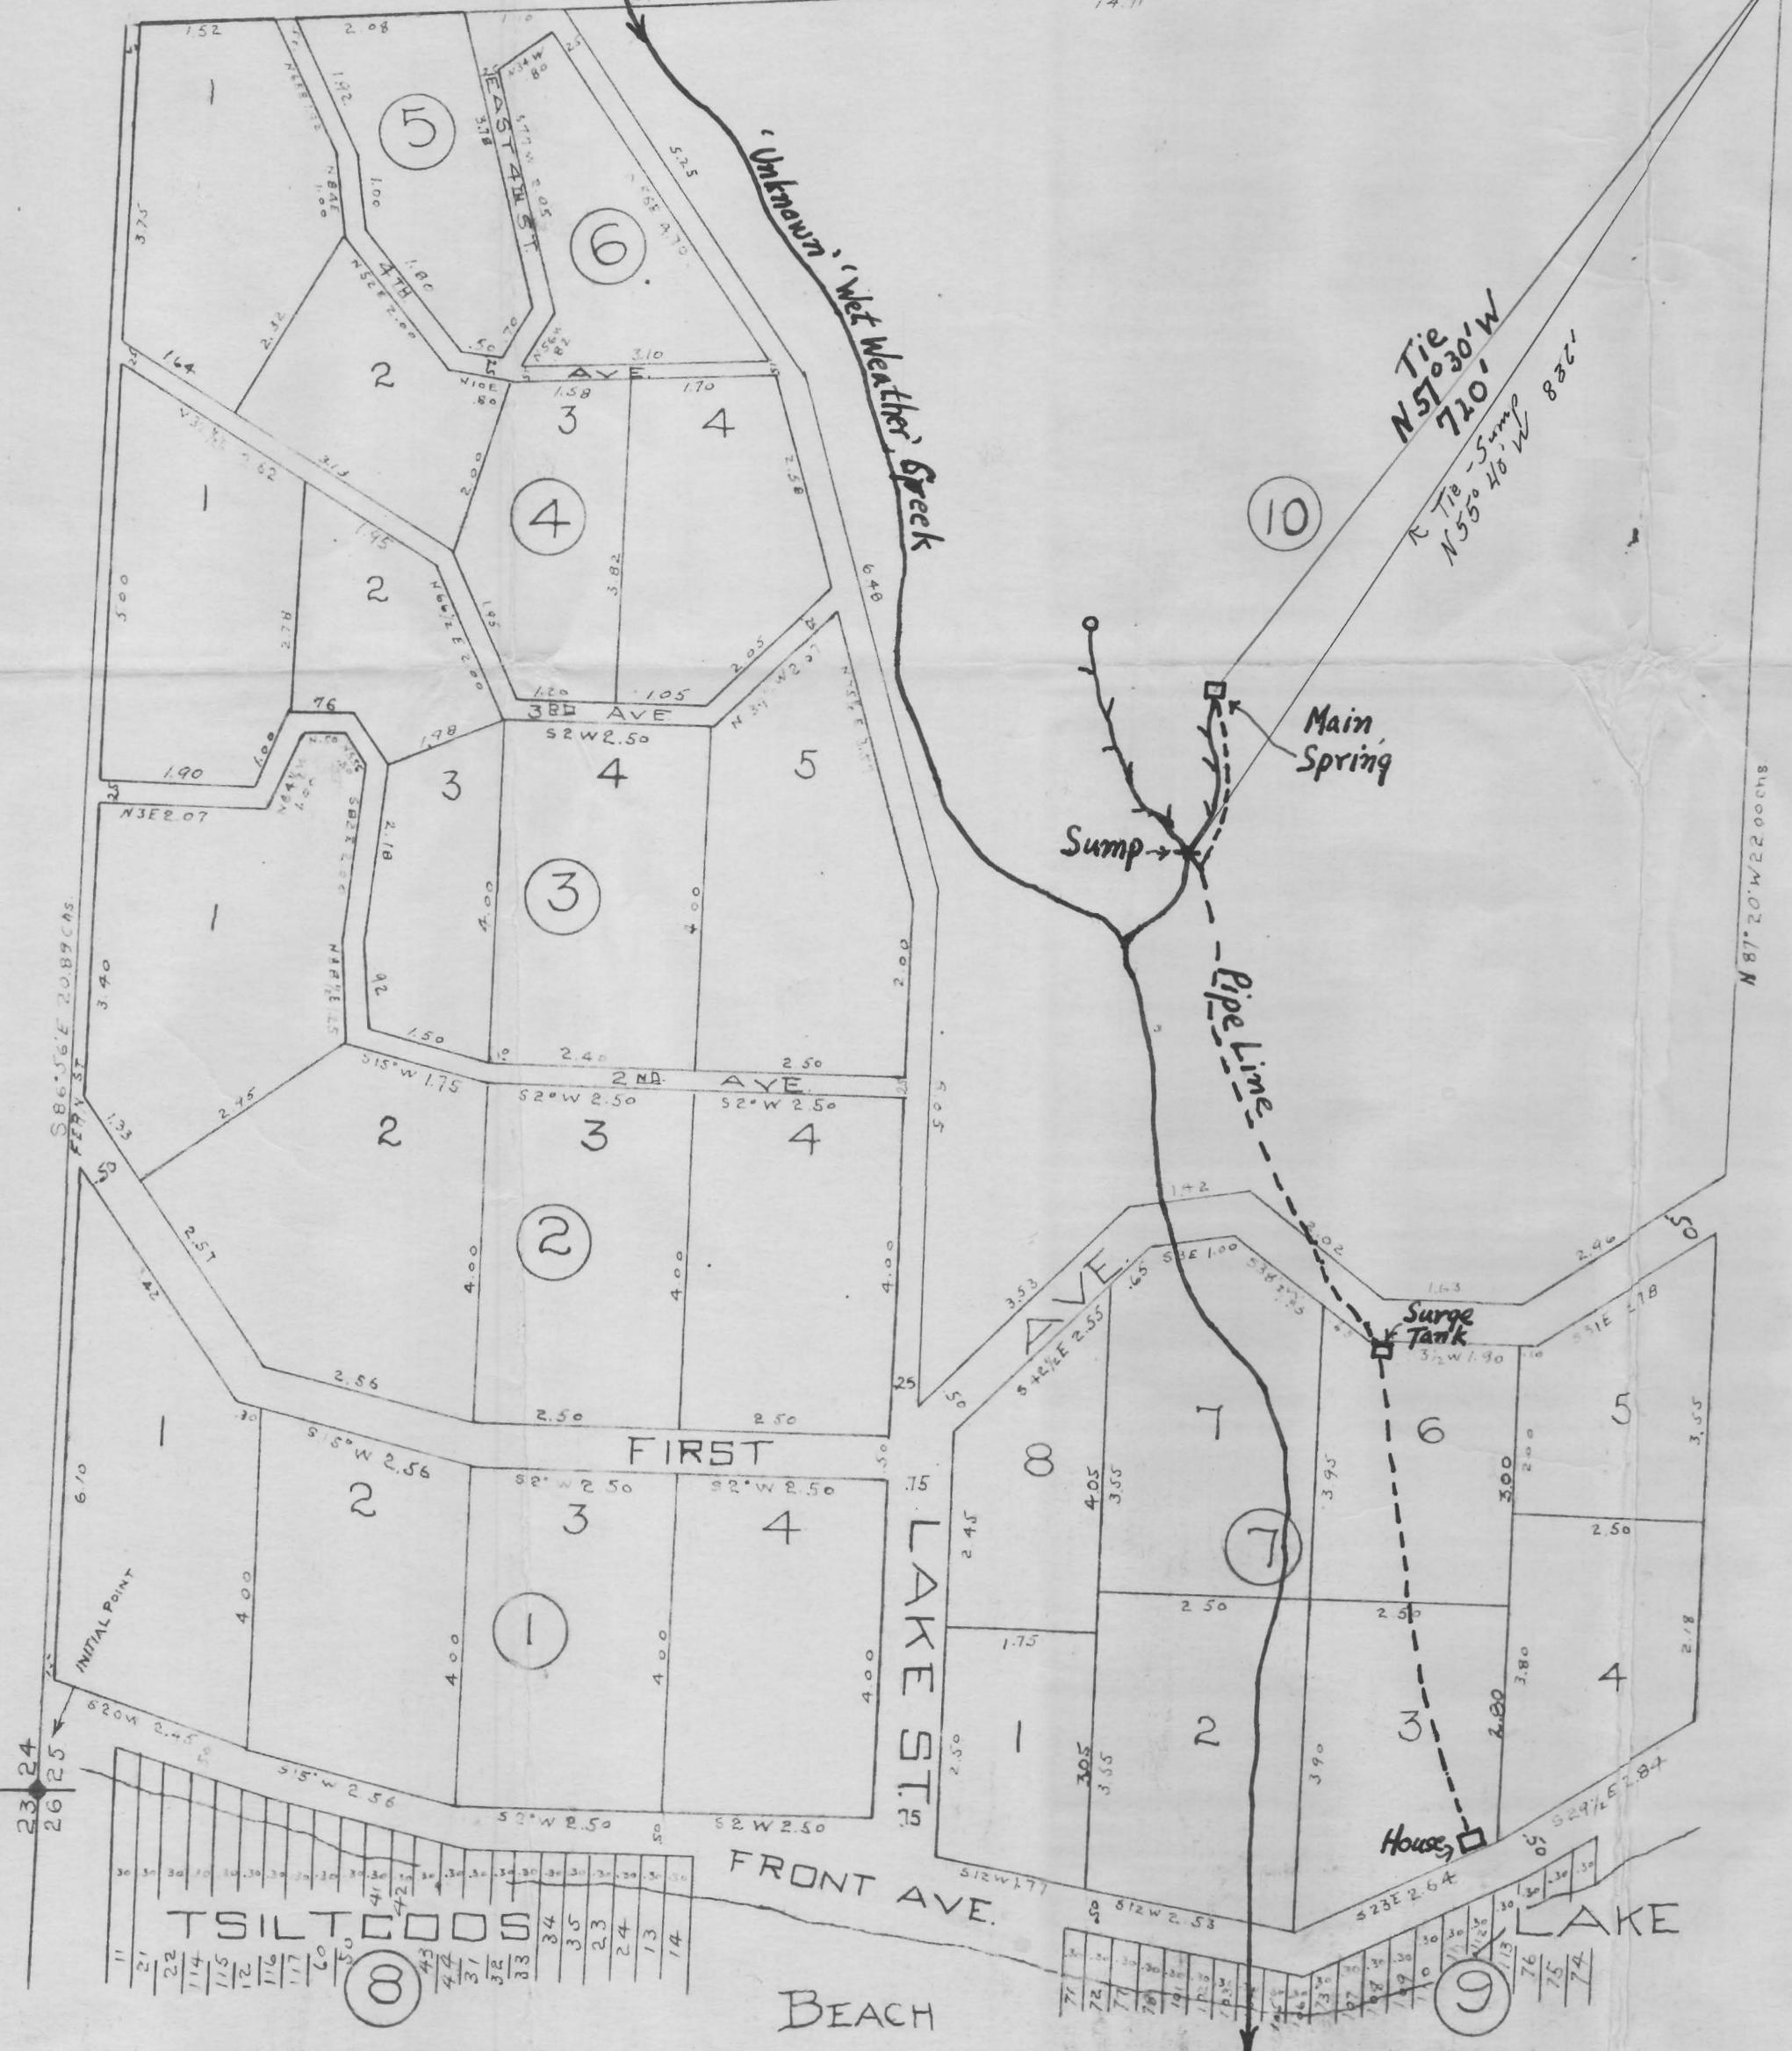

DESCRIPTION

Note: all distances in chains and links.

CERTIFICATE

State of Oregon
County of Lane } ss

I, James W. Ford, Jr. being first duly sworn, depose and say that I am a surveyor of Florence, Oregon, and that I have correctly surveyed and marked with proper monuments the lands represented on the plat of ERHART ACRES, Lane County, Oregon, and that I planted for the Initial Point of such survey a galvanized iron pipe 2" in diameter and 3' long, driven 6' below the surface of the ground, said point being the Section Corner to Sections 23, 24, 25 and 26 Twp. 19 So. Rge. 12 W. of Will. Mer.

Subscribed and sworn before me the 22 day of October 1914.

Ed. J. Walker

Notary Public

DEDICATION

I, John E. Hart, single, owner in fee simple, hereby lay out and establish the blocks and lots shown on the plot of ERHART ACRES, Lane County, Oreg., and dedicate to the public the streets and beach indicated thereon to be used as such forever. Witness our hands and seals this 3rd day of September, 1914.

Done in the presence of

Mr. Whitehead
July 10, 1938

ACKNOWLEDGMENT

State of Oregon }
County of Lane } ss

On this 5th day of October 1914 personally came before me the undersigned, a Notary Public in and for said County and State, the above mentioned William F. Clark,
unmarried to me personally known to be identical person described in and who executed the above instrument and acknowledged to me that he executed the same freely and voluntarily for the uses and purposes therin named.

Witness my hand and seal this first day of September 1914

End C. Warwick

Notary Public

Application No. 32036
Permit No. 26183