


SURVEYORS CERTIFICATE

I.W.E. Anderson of Tillamook Oregon do hereby certify that this map was made from notes taken during an actual survey made by me in July 1959, and that it correctly represents the works herein

W.E. Anderson 25

005
000

36

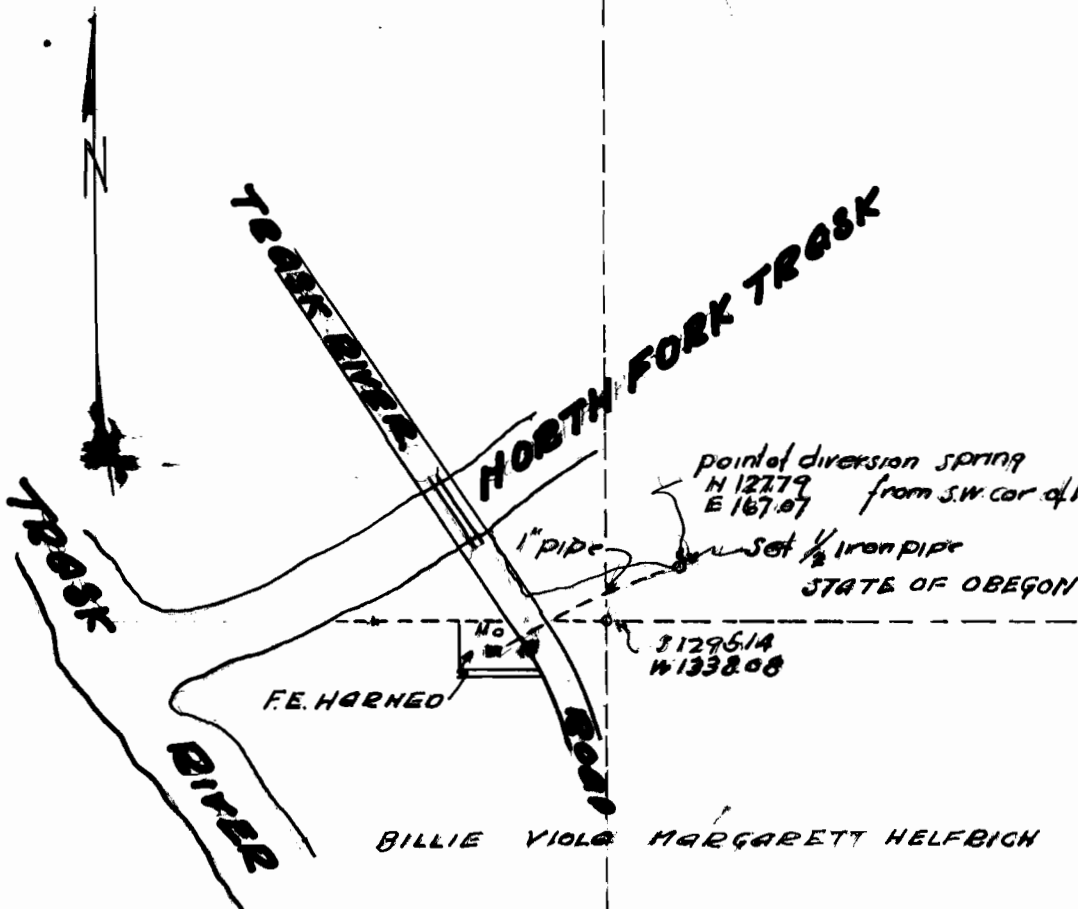

Application No. 33255

Permit No. 26292

F.E. HARNED SPRING WATER RIGHT

N 1/2 OF NE 1/4 & SW 1/4 NE 1/4 SEC 36 T.15. R.8 W.17
TILLAMOOK CO. ORE

Scale 1" = 400 July 1959

W.E. Anderson