


T.35 S. R.7 W.W.M.

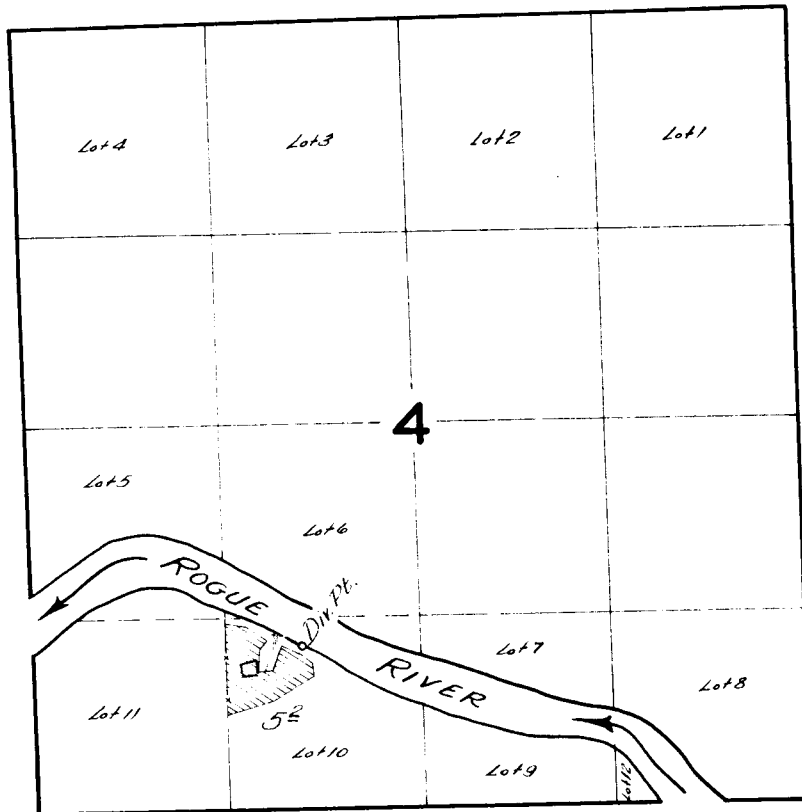

FINAL PROOF SURVEY
UNDER

Application No. 33069 Permit No. 26326
IN NAME OF

HARRY A. WILSON

Surveyed April 20 1961, by *CO Bartlett*