


# T.37S.R.6W.W.M.

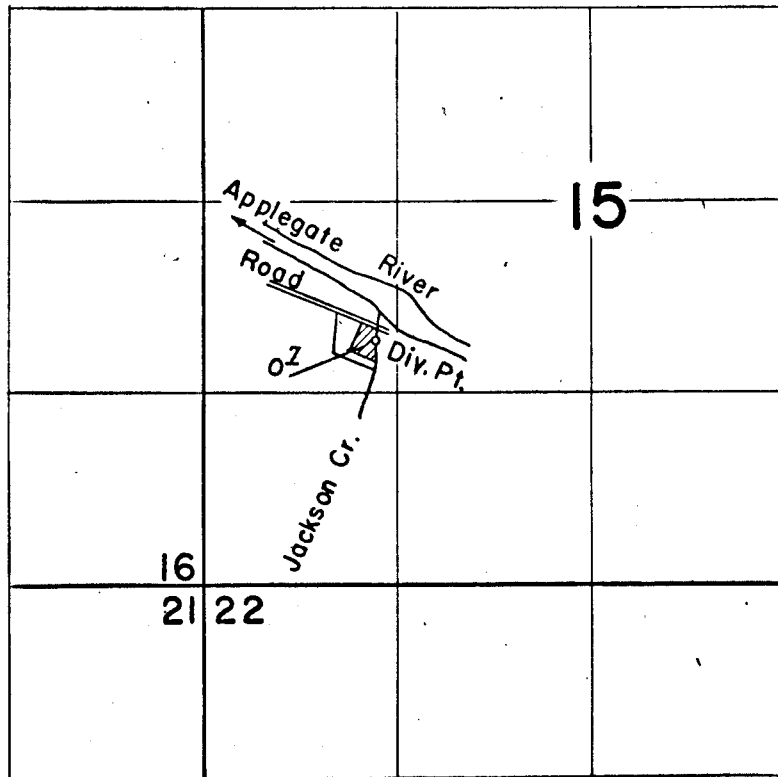

## FINAL PROOF SURVEY UNDER

Application No. 33156... Permit No. 26333...  
IN NAME OF

..... Homer C. Rand .....

Surveyed July 9... 1963, by R.H. Jackson.....