

APPROPRIATION


of

SPRINGS

by

M. D. Kelley

Tp. 16 S. R 41 E. WM.

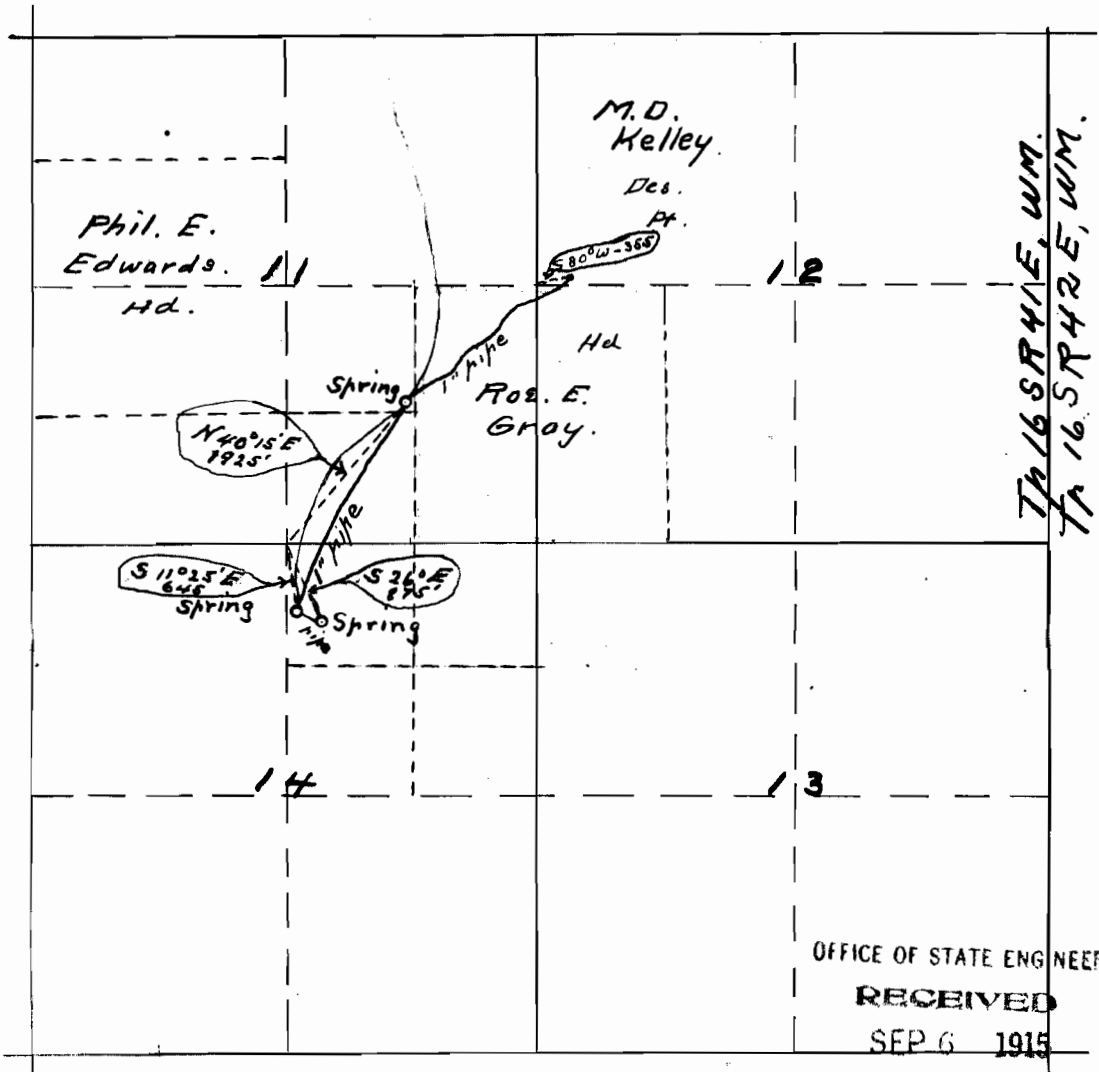

SALEM, OREGON,

4492

2636

I, J. F. Miller of Vale, Oregon do hereby certify

that this map was made from notes taken during an actual survey made by me on the 29th day of August 1915, and that it correctly represents the works described in the accompanying application together with location of streams and other ditches in the immediate vicinity

J. F. Miller
Civ. Engr.