


# TWP. 33 S. R 7 WMM

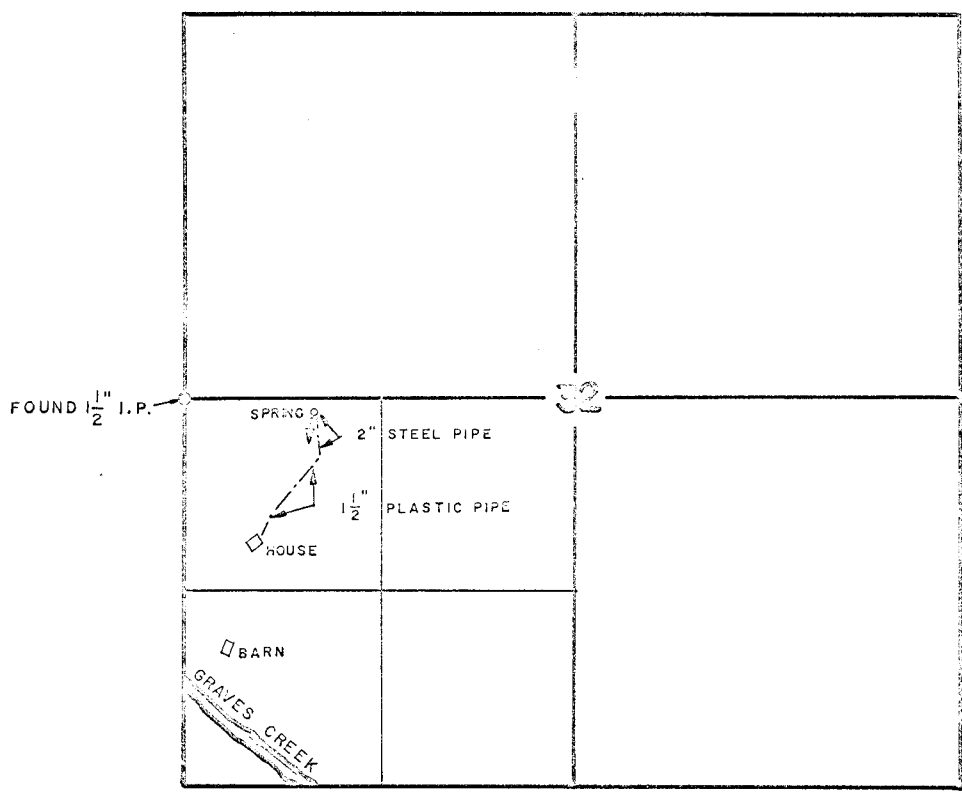

## FINAL PROOF SURVEY UNDER

SCALE: 4" = 1 MILE

Application No. 33370..... Permit No. 26378.....  
IN NAME OF

..... CLAUDE E. And LAVINIA A. MOORE .....

Surveyed .....6:14..... 1963, by R. STEIMER.....