Graydon Haga

Map accompanying an application for a water right on a spring in the N.E. 1/4 N.E. 1/4 Sec. 28 T. 28 S. R. 14 W. W. M.

Corners found this survey shown: ◎

Iron rods set this survey shown: o

Scale 1" = 100' Sept. 2, 1959

REGISTERED OREGON LAND SURVEYOR

J. E. Fahlamm

REGISTERED J. E. FAHLAMME 290

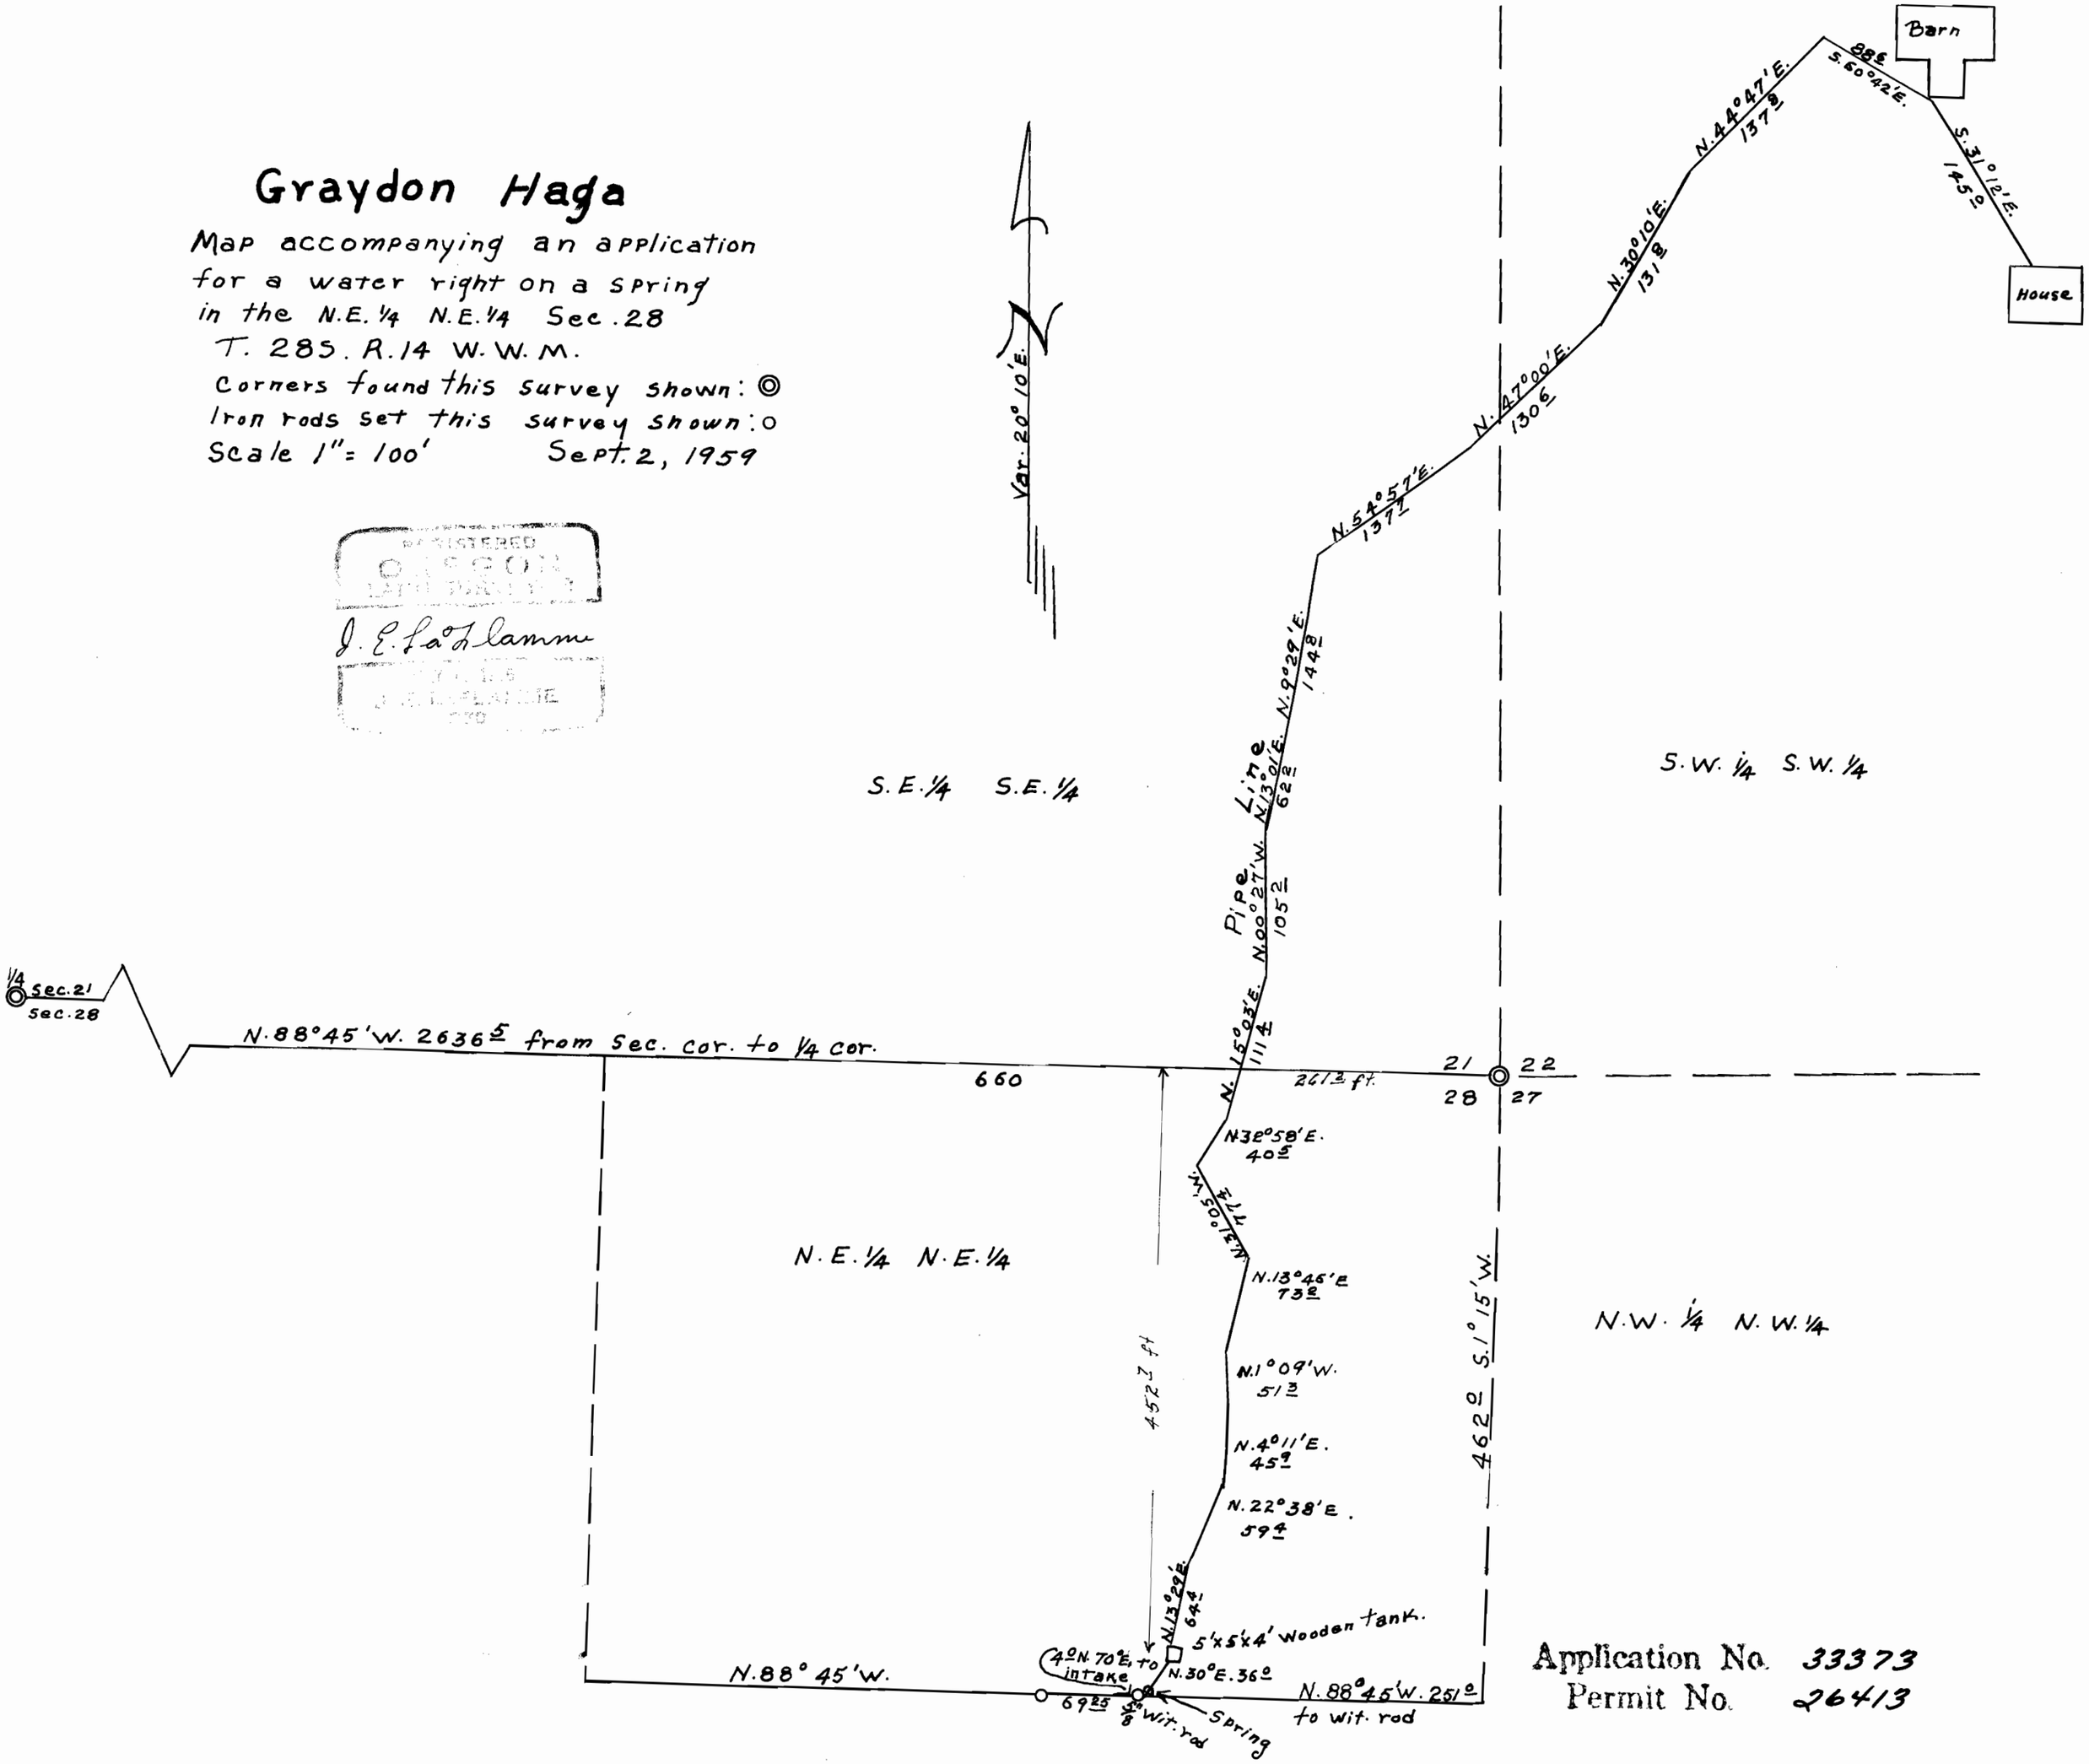

Application No. 33373
Permit No. 26413