


TWP. 39S. R.8 WWM

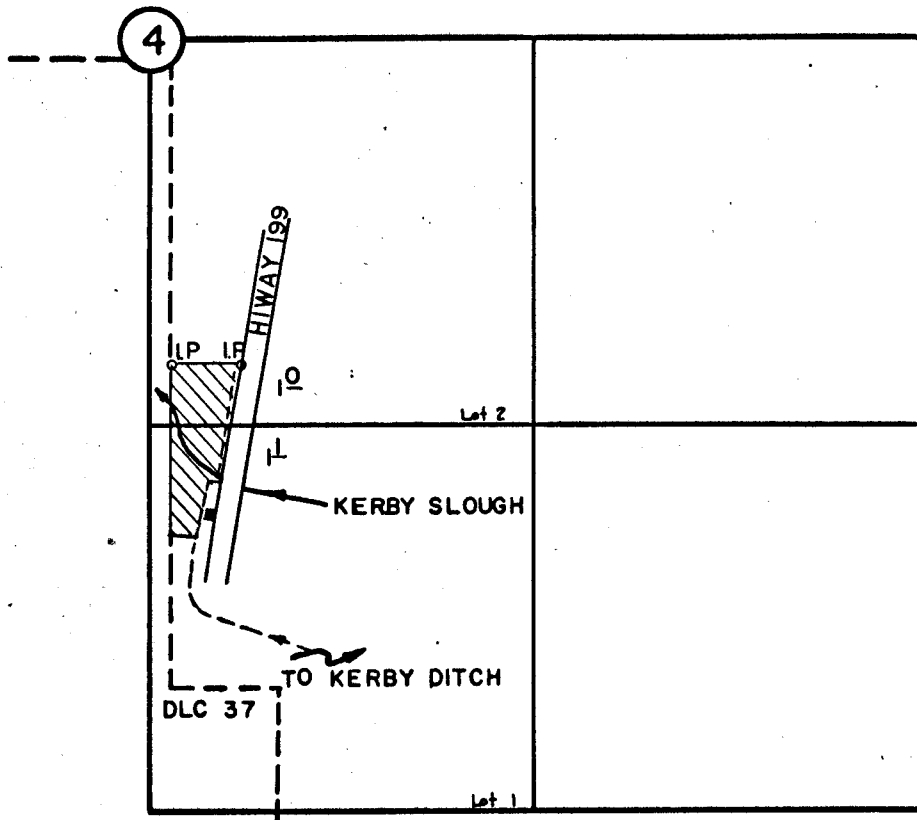

FINAL PROOF SURVEY

UNDER

Scale: 8" = 1 Mile

Application No. 33537 Permit No. 26523

IN NAME OF

FRANZ HALM

Surveyed 8-22 1963, by R. STEIMER