


T. 36 S., R. 4 W., W.M.

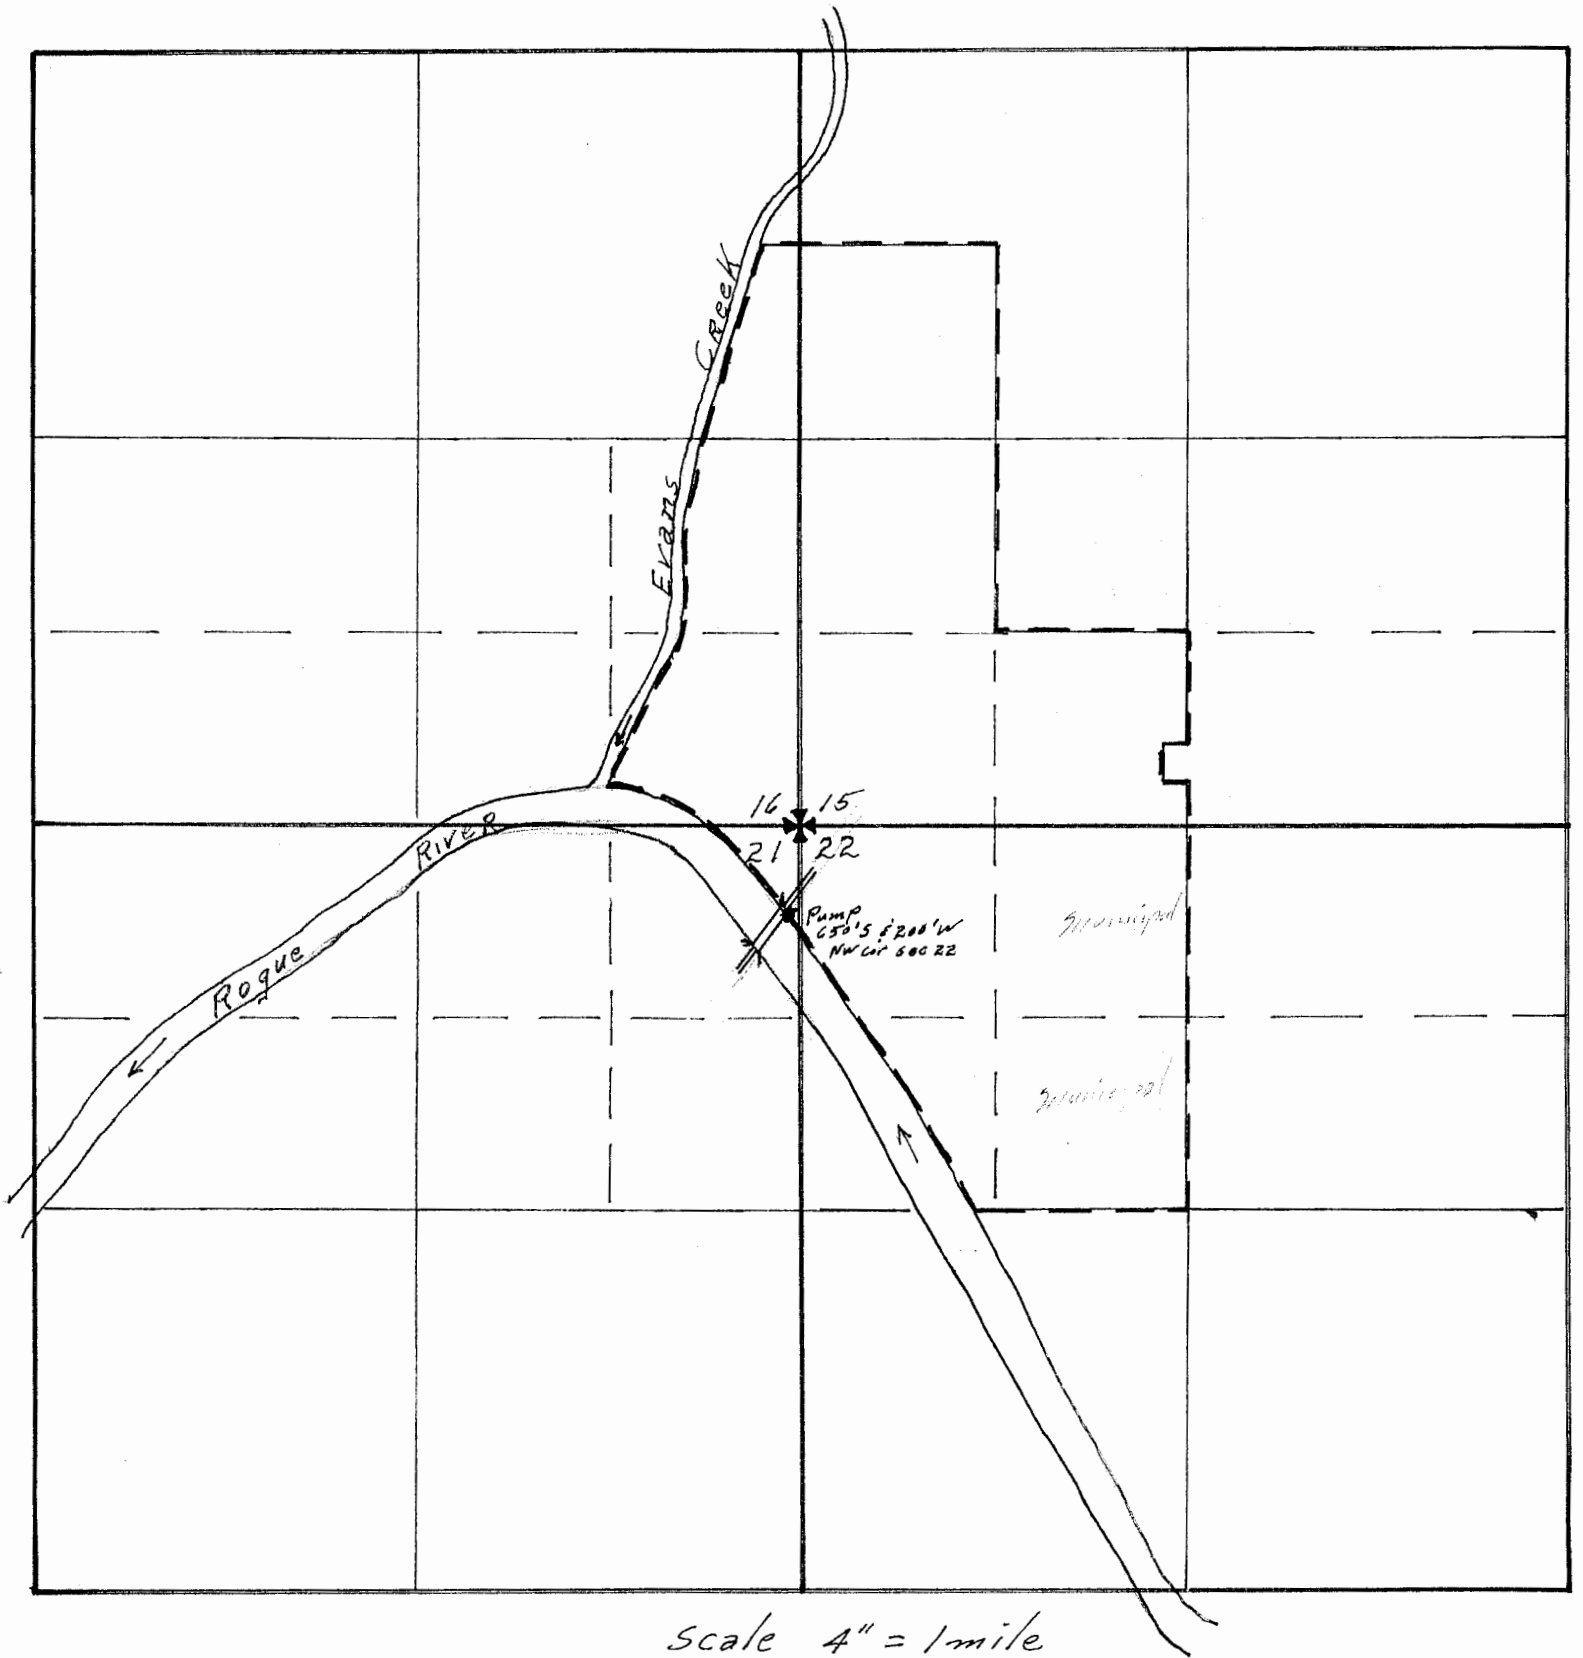

Scale 4" = 1 mile

Application No. 33661  
Permit No. 26594