

34-5-31

#26659


See Tr. 5127  
Ch. Pl. use  
70 S. of creek

31

SUPPLEMENTAL WATER FOR CARL  
HUSEN 3.9 ACRES FROM JUMPOFF  
JOE CREEK  
SCALE 8" = 1 MILE

TWP 34S R5W  
SECTION 31

By STEIMER

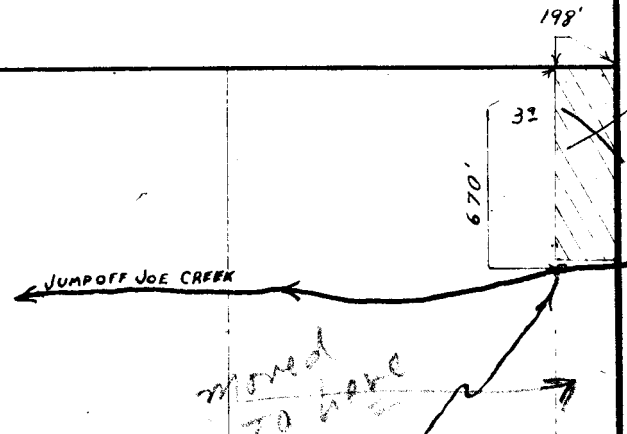

POINT OF DIVERSION  
198' W AND 670' S  
OF NE CORNER OF  
THE SE 1/4 OF SEC. 31

Application No. 33766  
Permit No. 26659