


T2S, R3E, W.M.

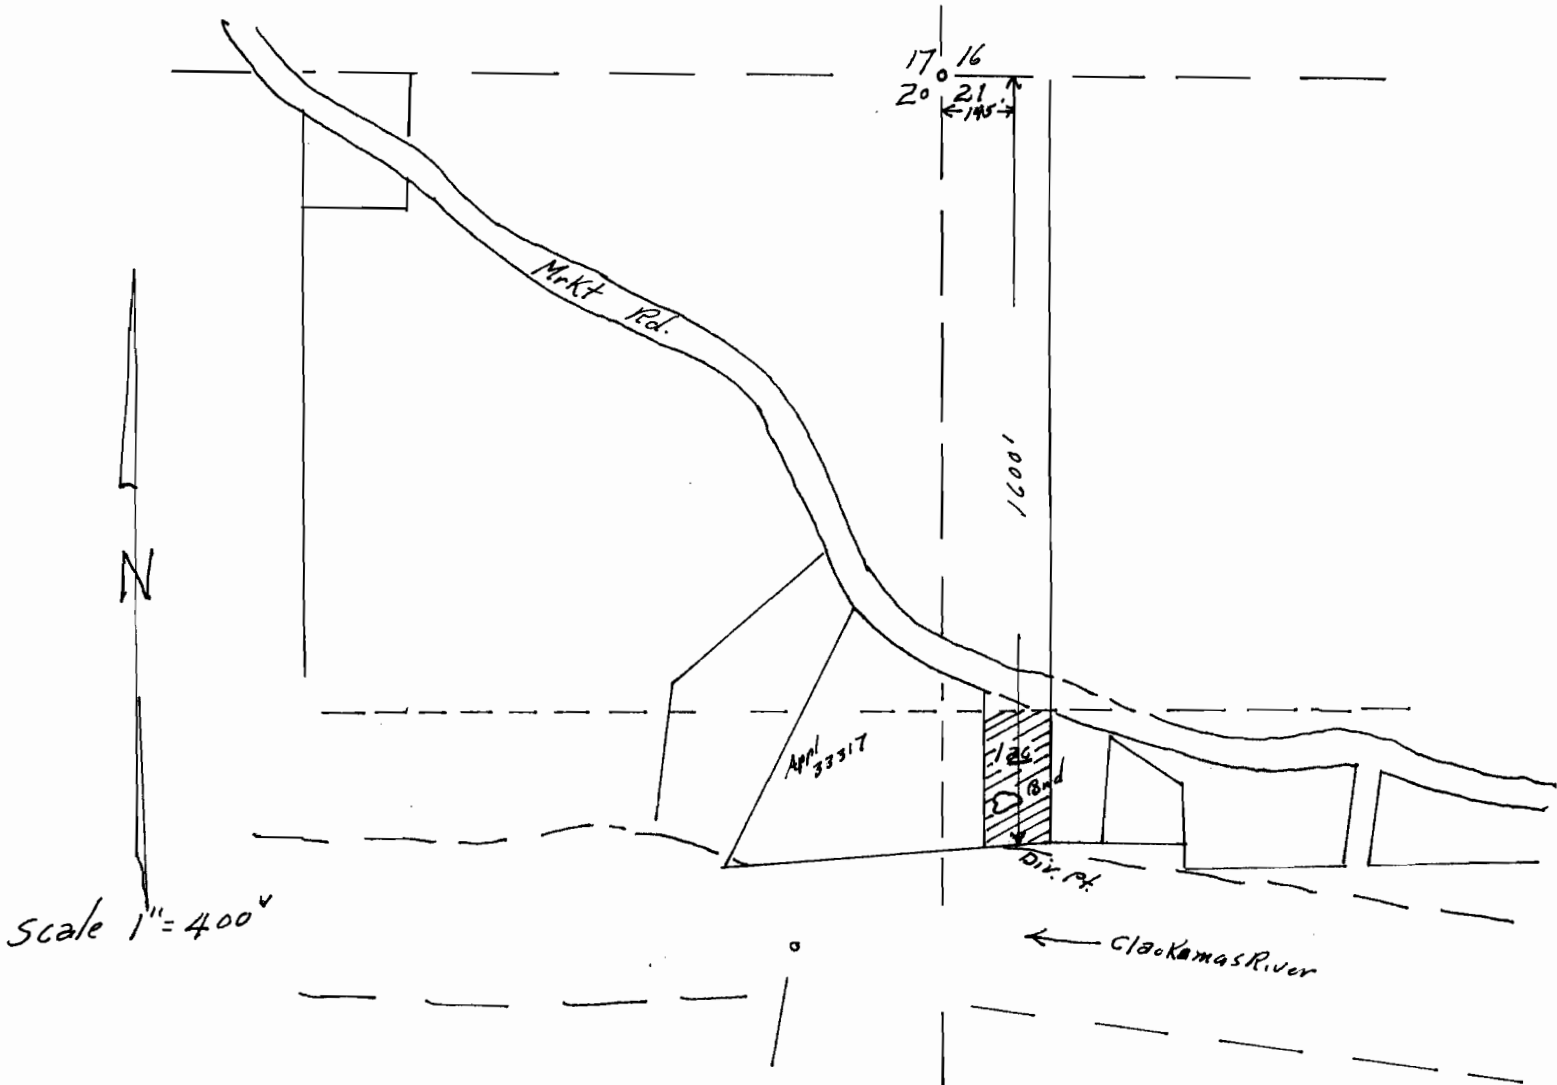

Application No. 33869
Permit No. 26696