


T. 40 S. R. 8 W. W. M.

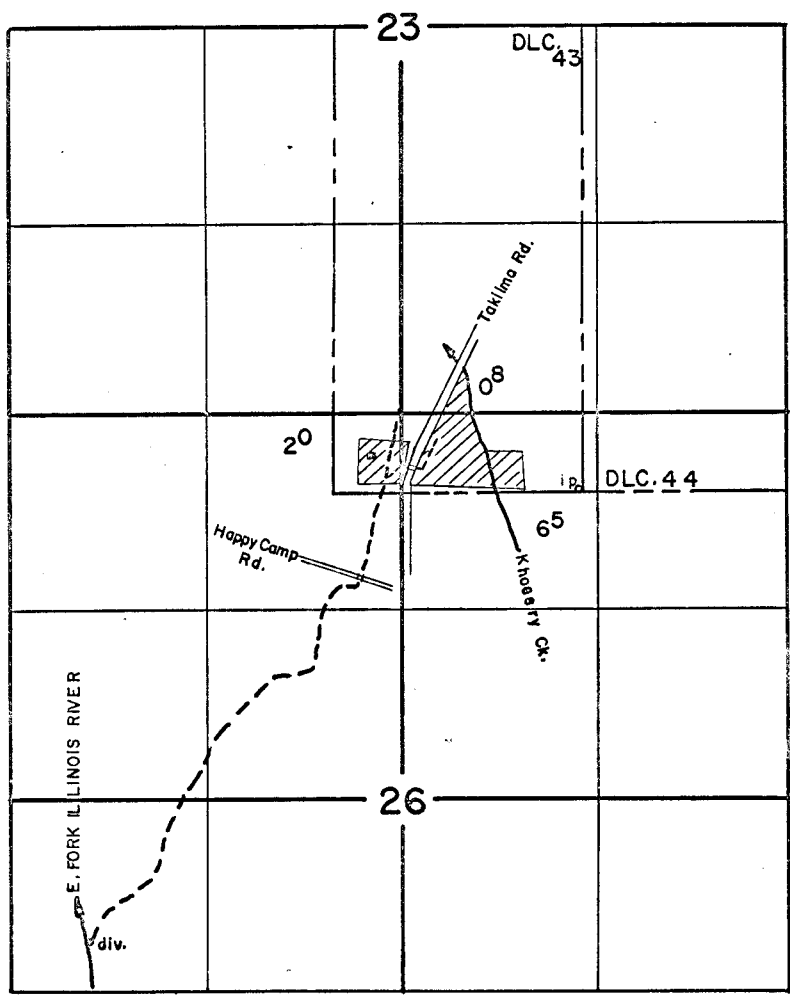

FINAL PROOF SURVEY UNDER

Application No. 33887... Permit No. 26705...
IN NAME OF

.....SPIERS...L...&...MARY.....

Surveyed May. 10... 1965., by ..R..B..Steimer...