


PACIFIC OCEAN

36

31

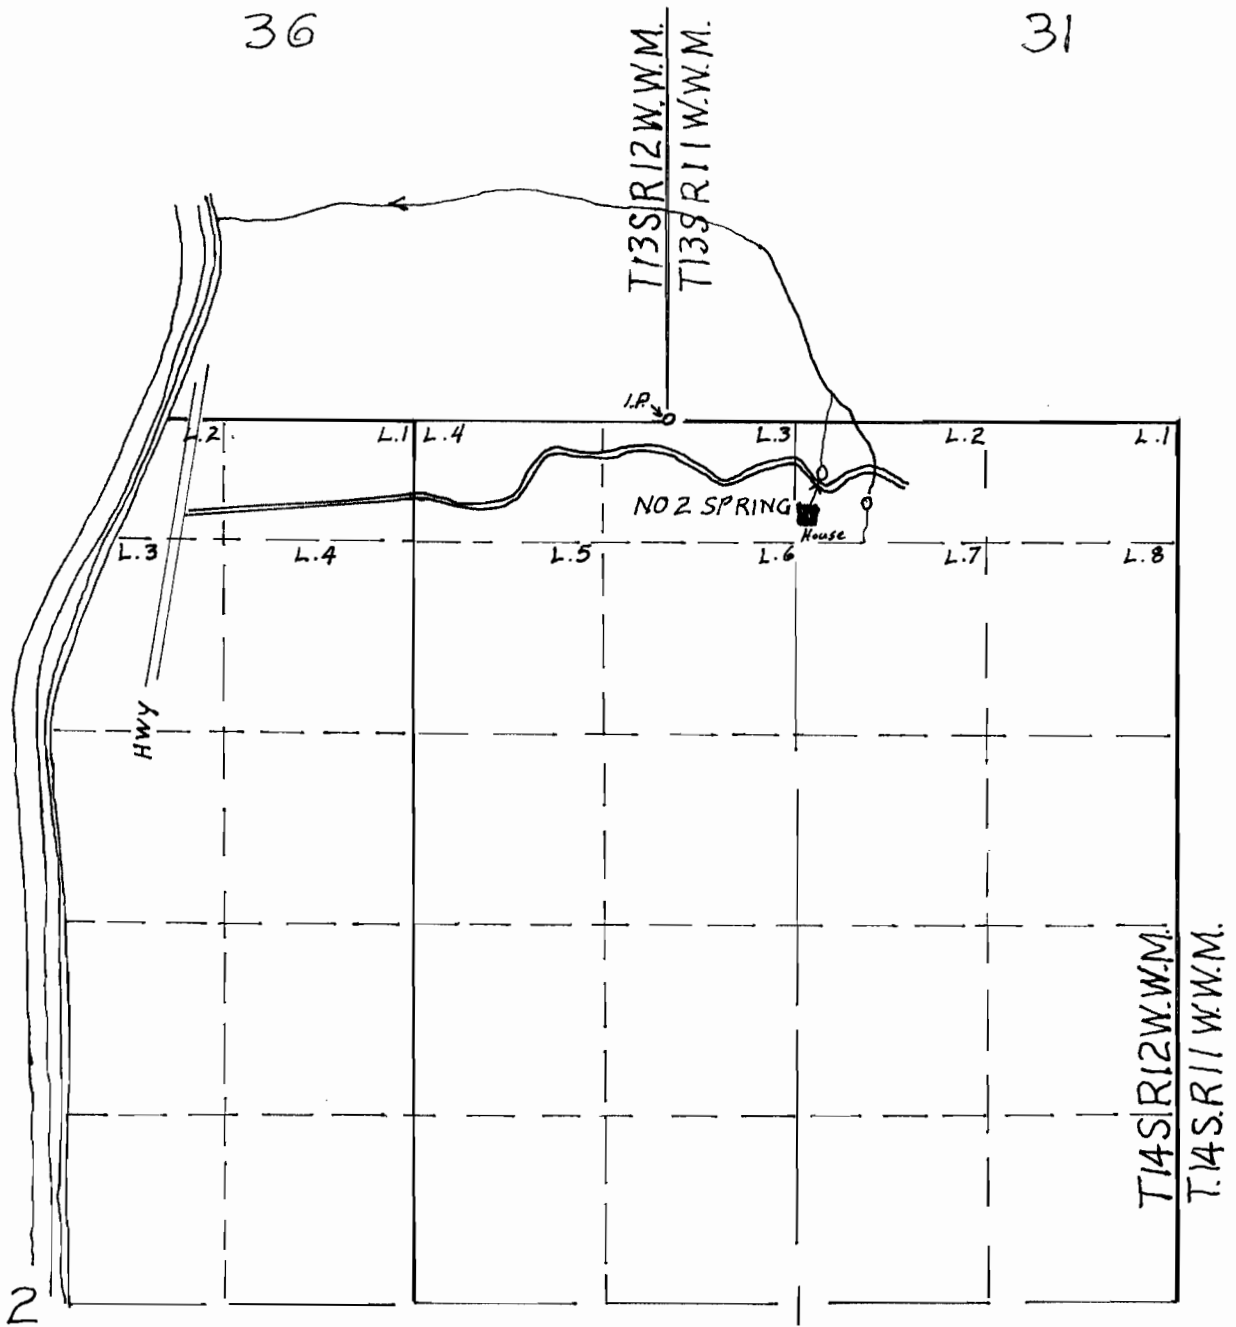

SPRING No 2 - 490 ft S & 100 ft. E of NW cor Lot 2

Application No. 33674
Plat No. 26733