


15 - *Shannon*  
38-8-11+  
12

# T. 38S. R. 8W.W.M.

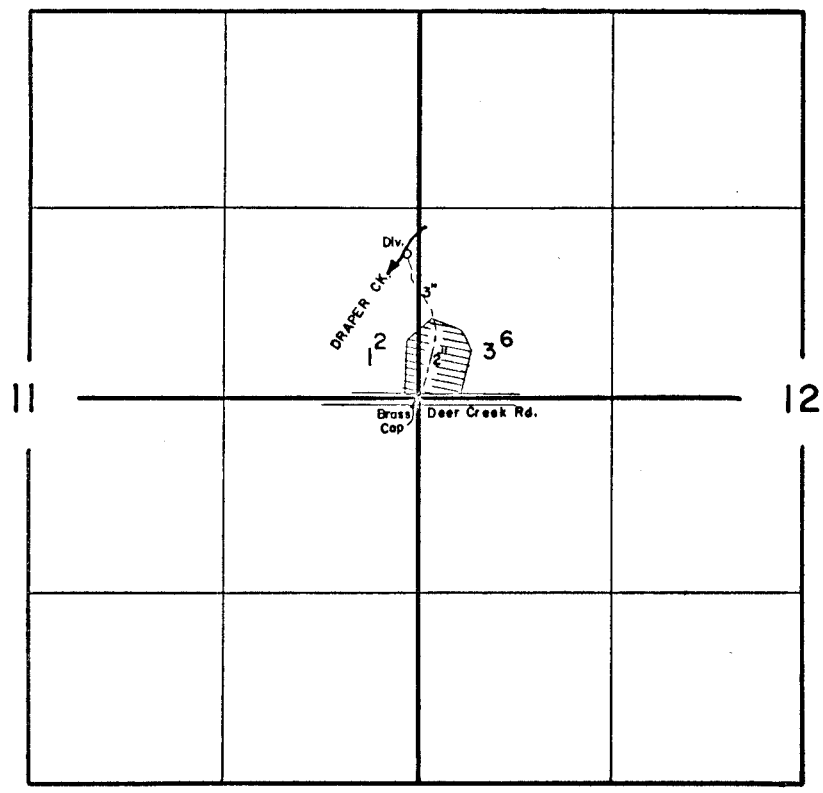

## FINAL PROOF SURVEY UNDER

Application No. 33896 Permit No. 26810  
IN NAME OF

FRITZ KRAUSS

Surveyed JULY 7, 1964, by R.B. STEIMER