


23957
37-9-01

T.37S. R.9W.W.M.

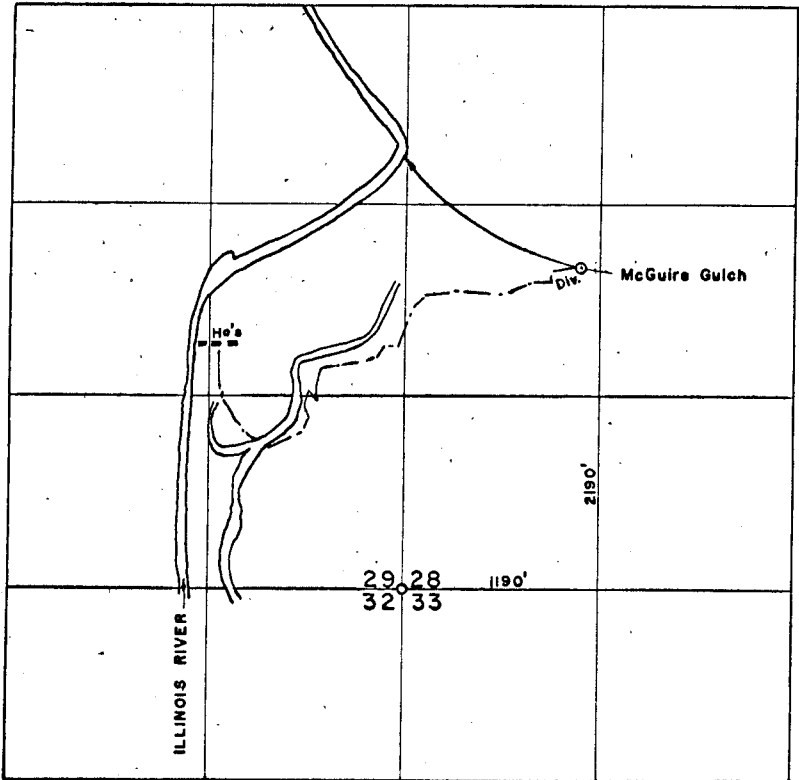

FINAL PROOF SURVEY UNDER

Application No. 33988 Permit No. 26820
IN NAME OF

ERNEST A. FOSTER

Surveyed Sept. 24, 1968, by R.B. Steimar