
WATER RIGHT
CHESTER A ILLINGSWORTH
SEC 23, TIN, RIOW W.M.
SCALE- I" = 200'

I. M. A. Markham, of Arch Cape,
Oregon, do hereby certify that this map
was made from notes of an
actual survey made by me on
August 6, 1960.
WAMwkham

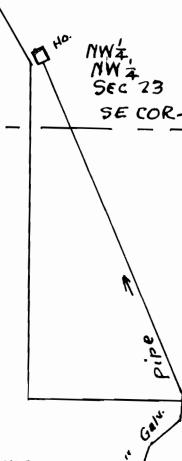


Point of Diversion

5885.1

W316.2

Application No. 34109
Permit No. 26884