


T. 34 S., R. 1 W., W.M.

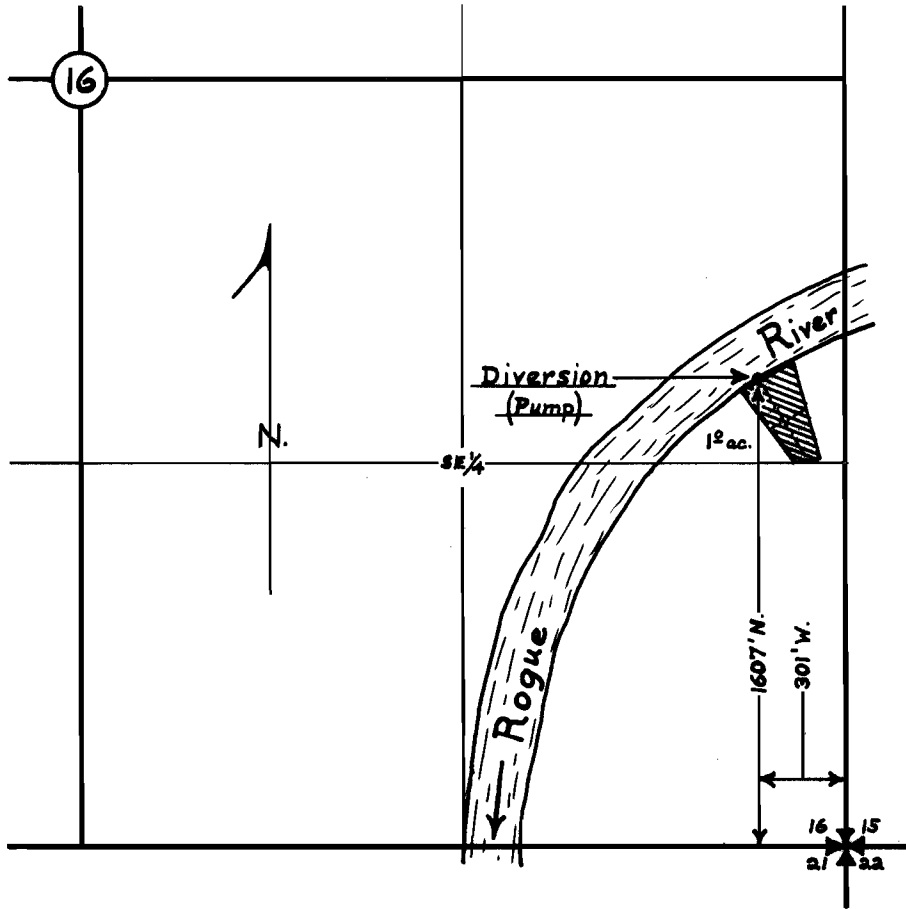

Application map for Harold J. & Retta L. Reith

July 2, 1960 Scale: 8 inches = 1 mile

Map prepared by David C. Hendrix

Application No. **34114**
Permit No. **26888**