


Application No. 34169  
Permit No. 26918

T. 2 S. R. 1 E. W. 1 M.  
Sec. 1

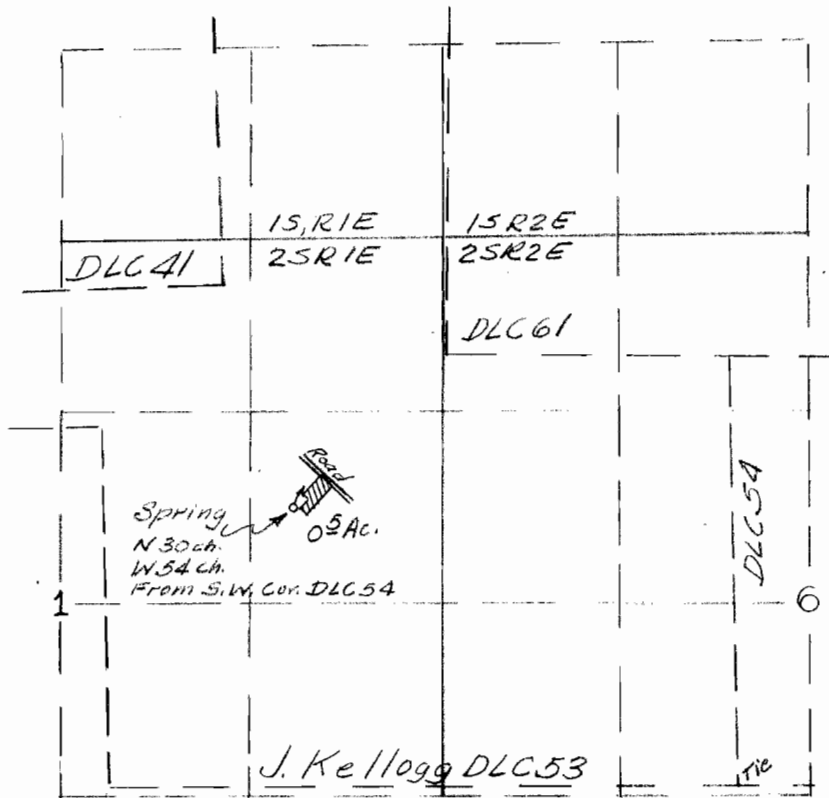

Application Map for Permit to appropriate  
the public waters of the State of Oregon  
In Name of

Mildred J. Johnston  
Clackamas County, Oregon