

Township 38 S Range 5 W

Josephine County Or

GLASS & FREDMONNE CO., PRINTERS, PORTLAND. 115493

		26	

About two or three  
 under ditch, situated in  
 S.W. 1/4 of S.E. 1/4 of Sec - 26  
 T. 38 S - R - 5 - W of W.M.

Application No. 4607 OFFICE OF STATE ENGINEER


Permit No. 2701 RECEIVED

NOV 5 1915

SALEM, OREGON,

Estimated by Ed Davis

Township No. 39 Range 5 N. W. M.  
 -----  
 County, -----

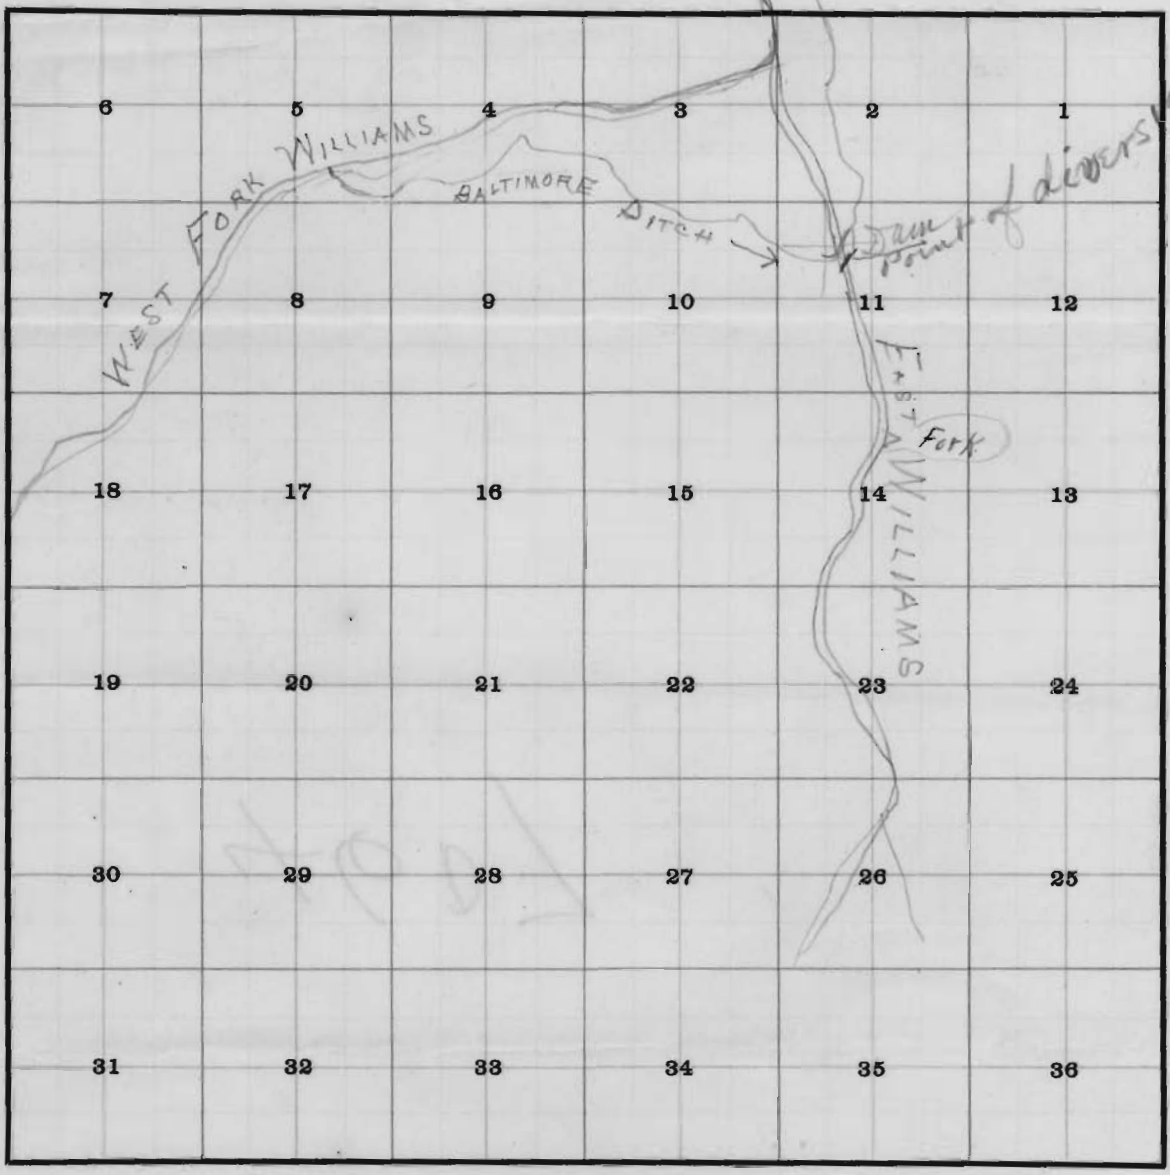


STATE OF OREGON

OFFICE OF STATE ENGINEER  
**RECEIVED**  
 NOV 5 1915

SALEM, - OREGON.

Application No. 4607  
 Permit No. 2701

Township No. 38 Range 5 : 21 E. W. M.  
County, \_\_\_\_\_

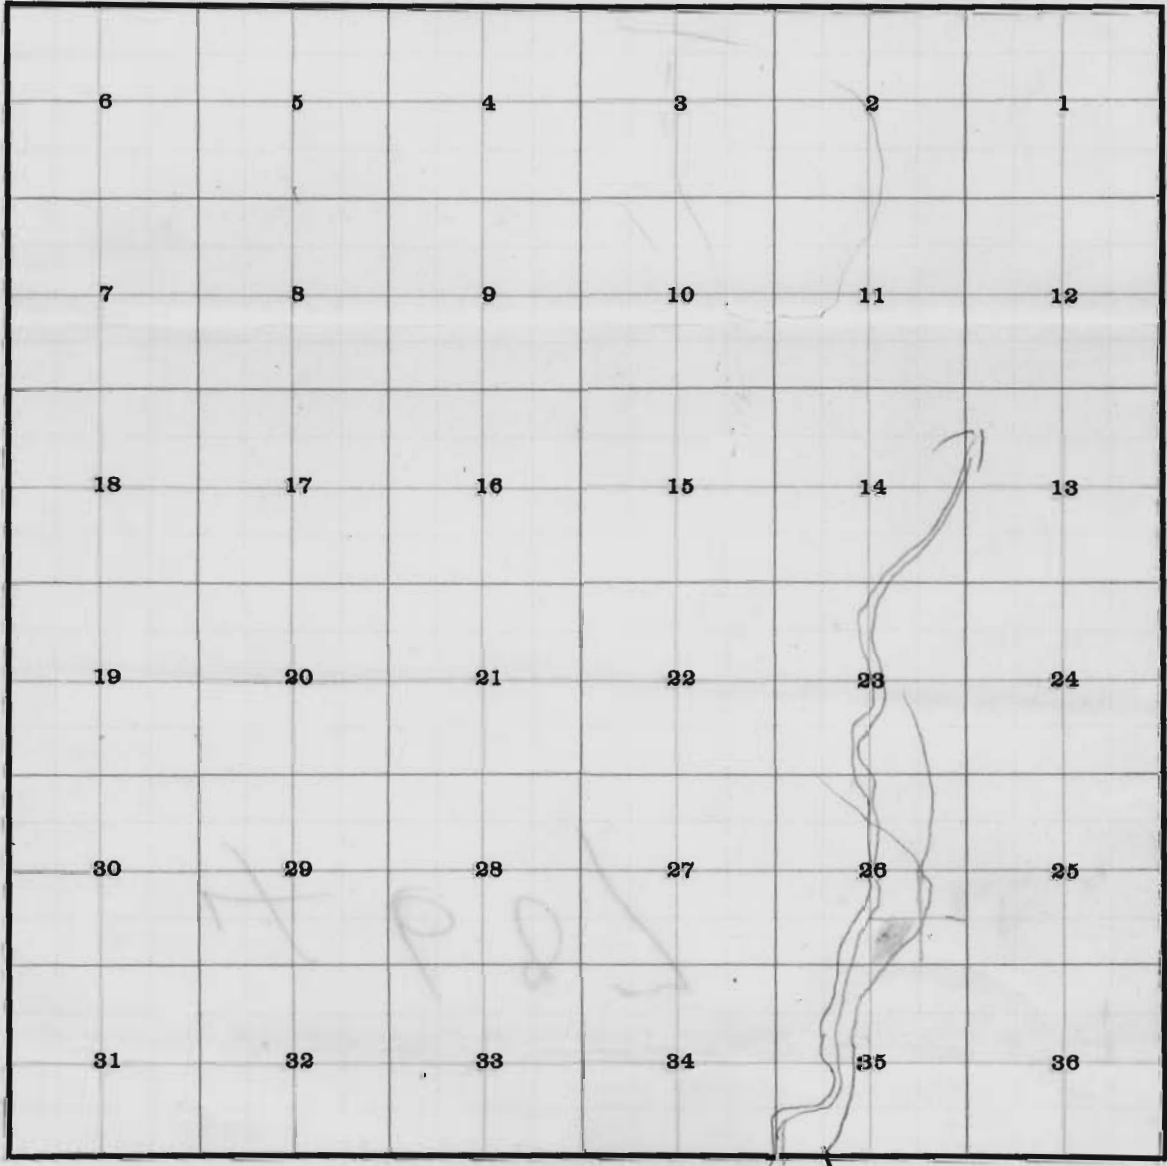

WILLIAMS CREEK →  
BALTIMORE DITCH →

OFFICE OF STATE ENGINEER  
**RECEIVED**  
NOV 5 1915  
SALEM, OREGON,

Application No. **4607**  
Permit No. **2701**