


Application No. 34412
Permit No. 27030

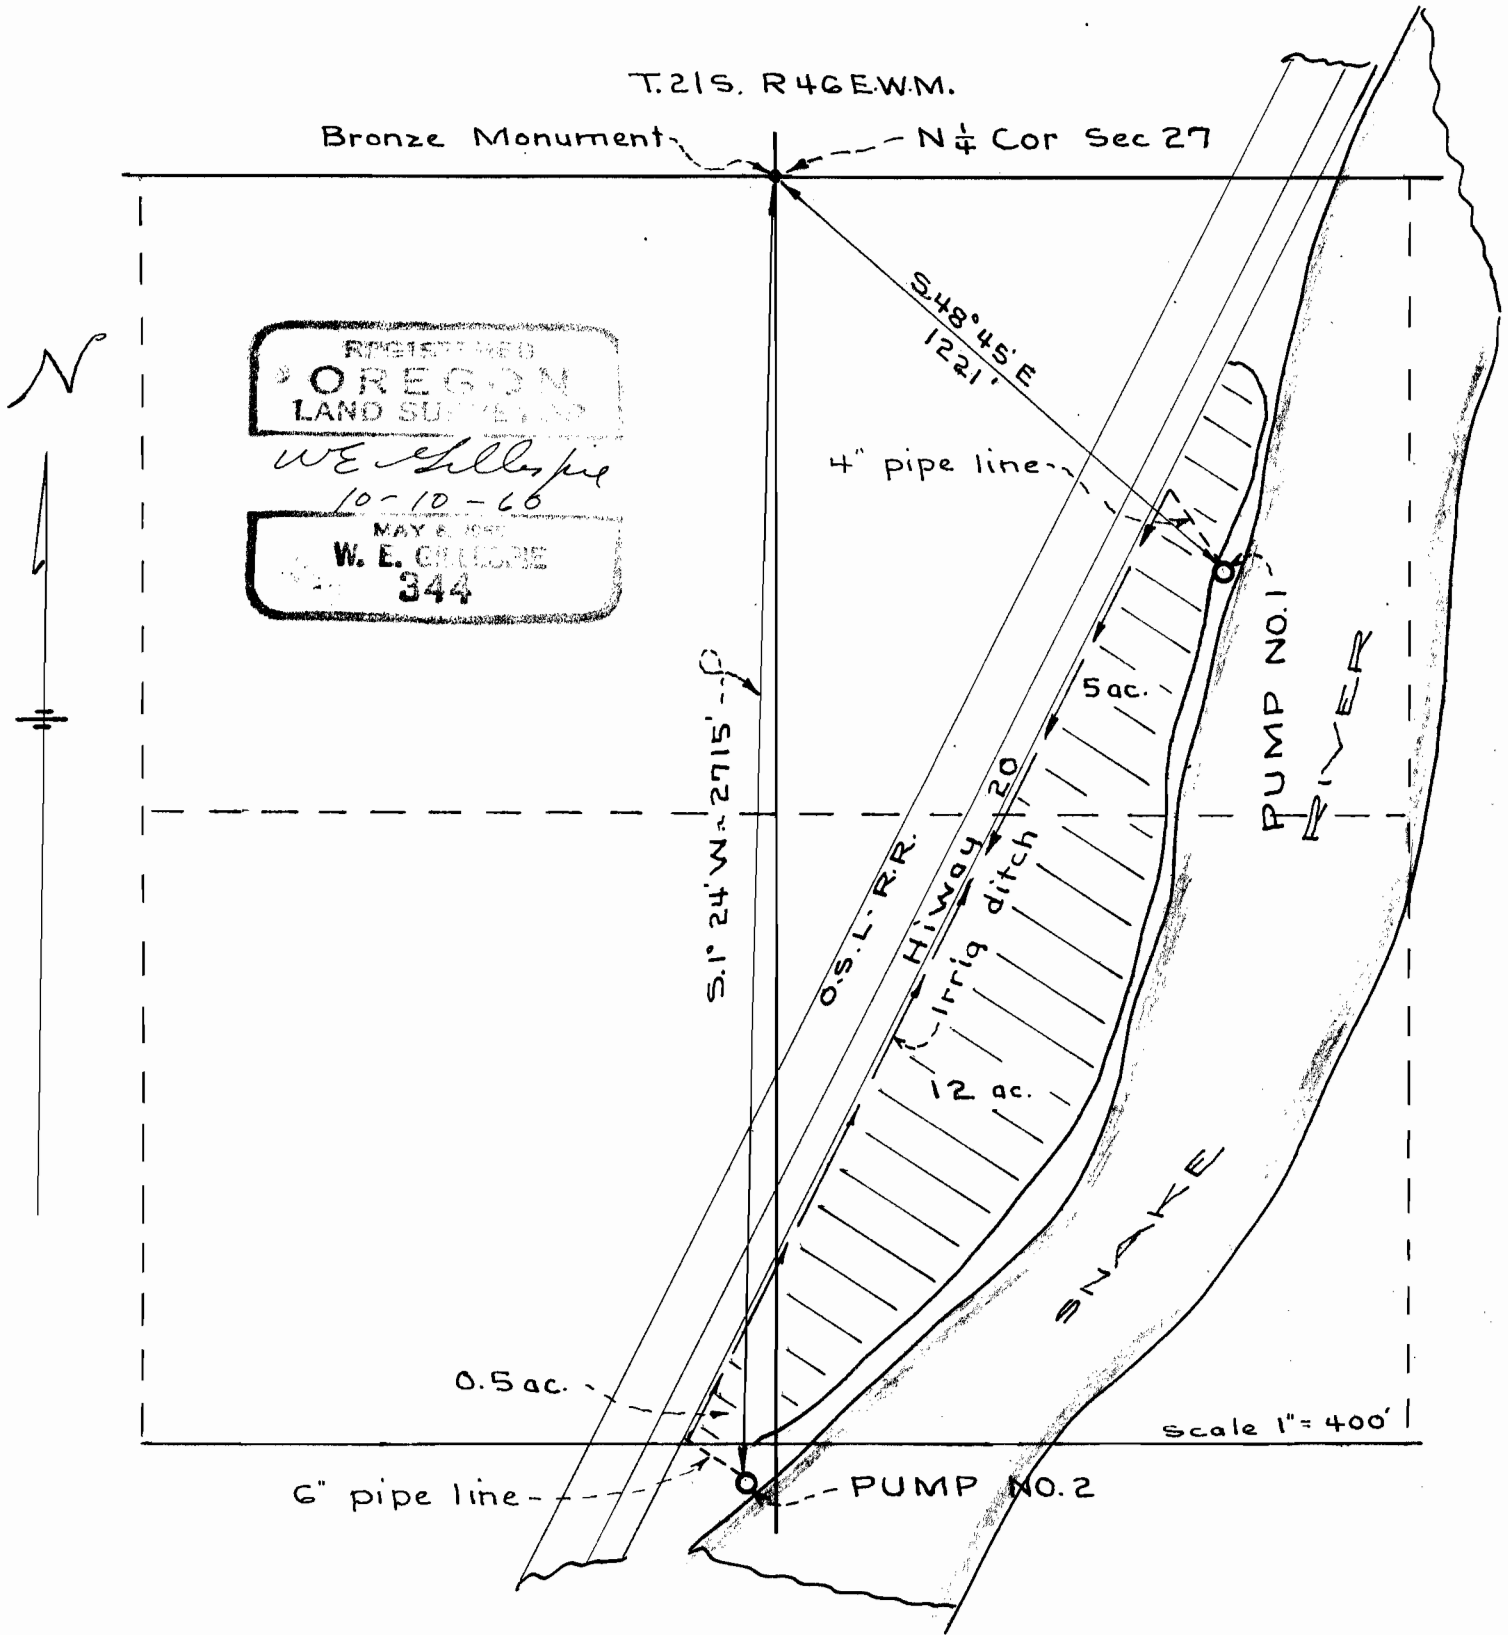

APPLICATION FOR PERMIT
M.H. Pitcher, Adrian, Ore.