


Per. 27066
35-8-1

T.35S.R.8W.W.M.

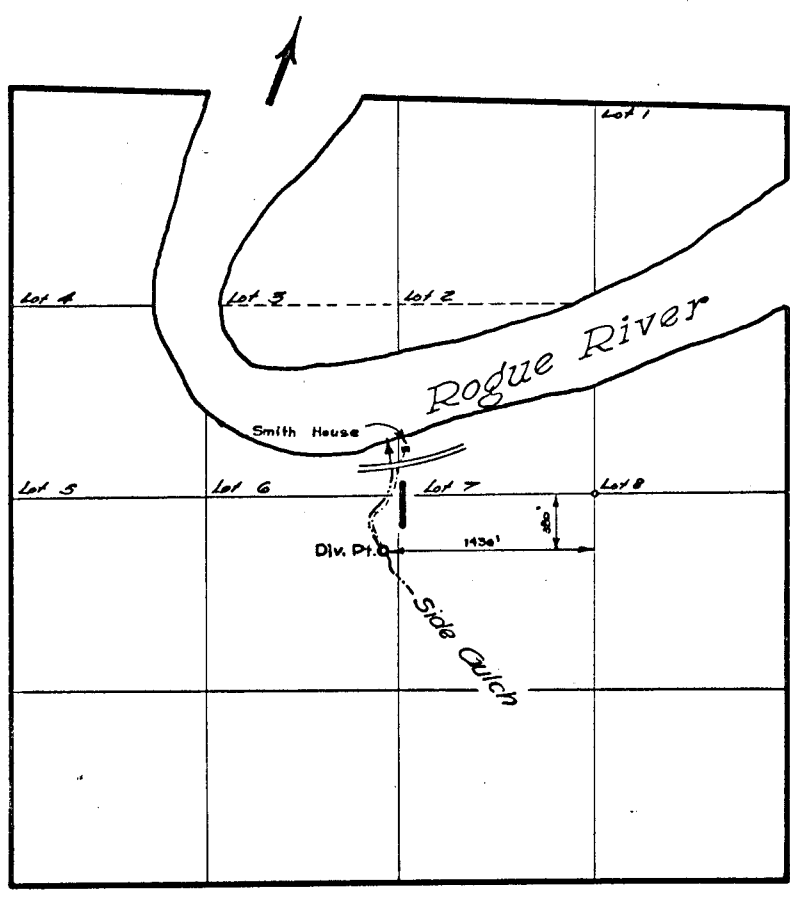

FINAL PROOF SURVEY UNDER

Application No. 34452... Permit No. 27066...
IN NAME OF
JOE & MILDRED E. KUCERA
...SHERMAN...S...&...MARY...L...SMITH

Surveyed July 13, 1965, by *[Signature]*