


27115

T.36S. R.7W. W.M.

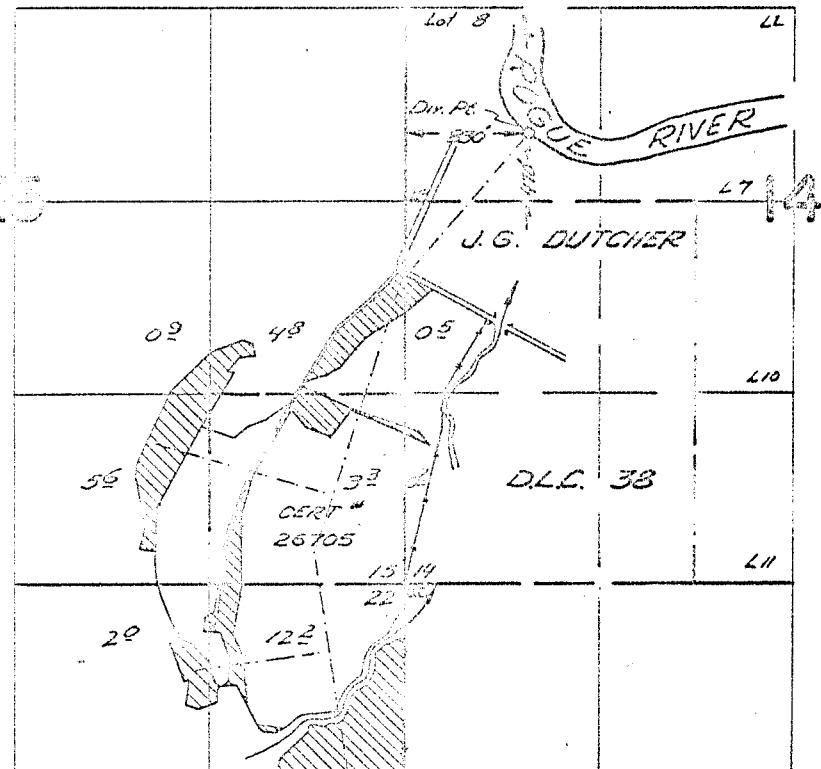

FINAL PROOF SURVEY
UNDER

Application No. 34528 Permit No. 27115
IN NAME OF

PHILLIP J. HUSSEY

Surveyed May 25, 1967, by V. Germer

1967-C