


Application No. 34570
Permit No. 27151

TWP 38 S R 5 W W M

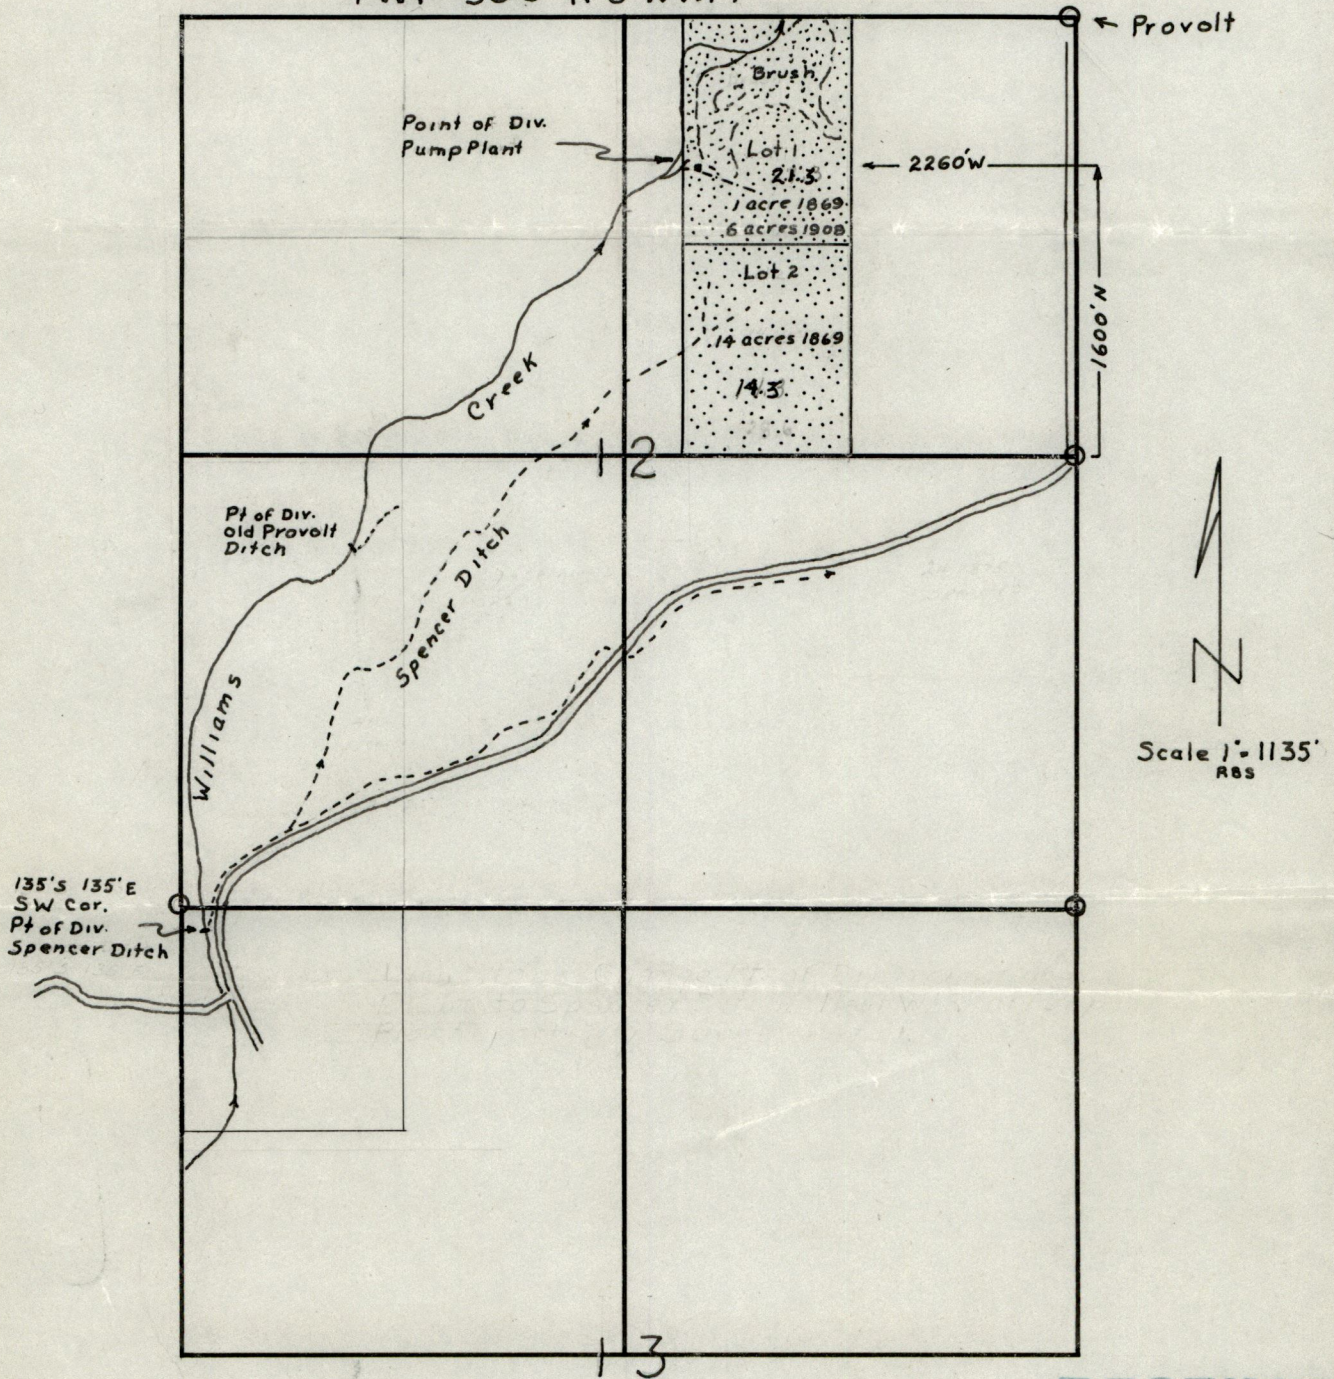

Lynn Stone Change Pt of Div. from Pump Plant
to Spencer Ditch New W/R at Pump Plant partially
Supplemental

RECEIVED
FEB 16 1961
STATE ENGINEER
SALEM, OREGON