


T 35 S R 7 W M

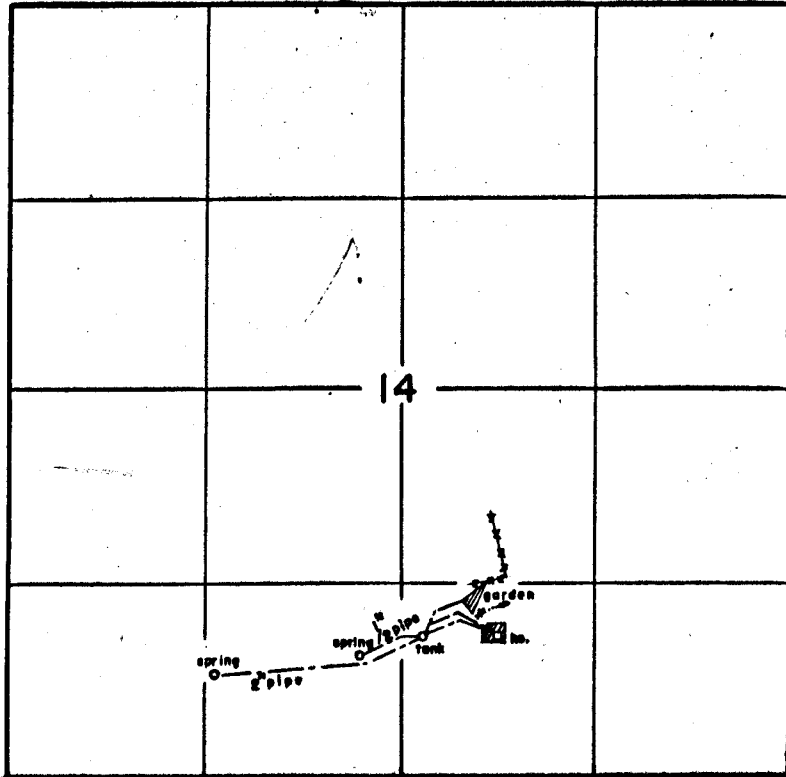

FINAL PROOF SURVEY
UNDER

Application No. 34612..... Permit No. 27178...
IN NAME OF

.....WILLIAM C. DEONIER.....

Surveyed JULY.26. 1963., by ...R.B. STEIMER