


T.39S.R.8W.W.M.

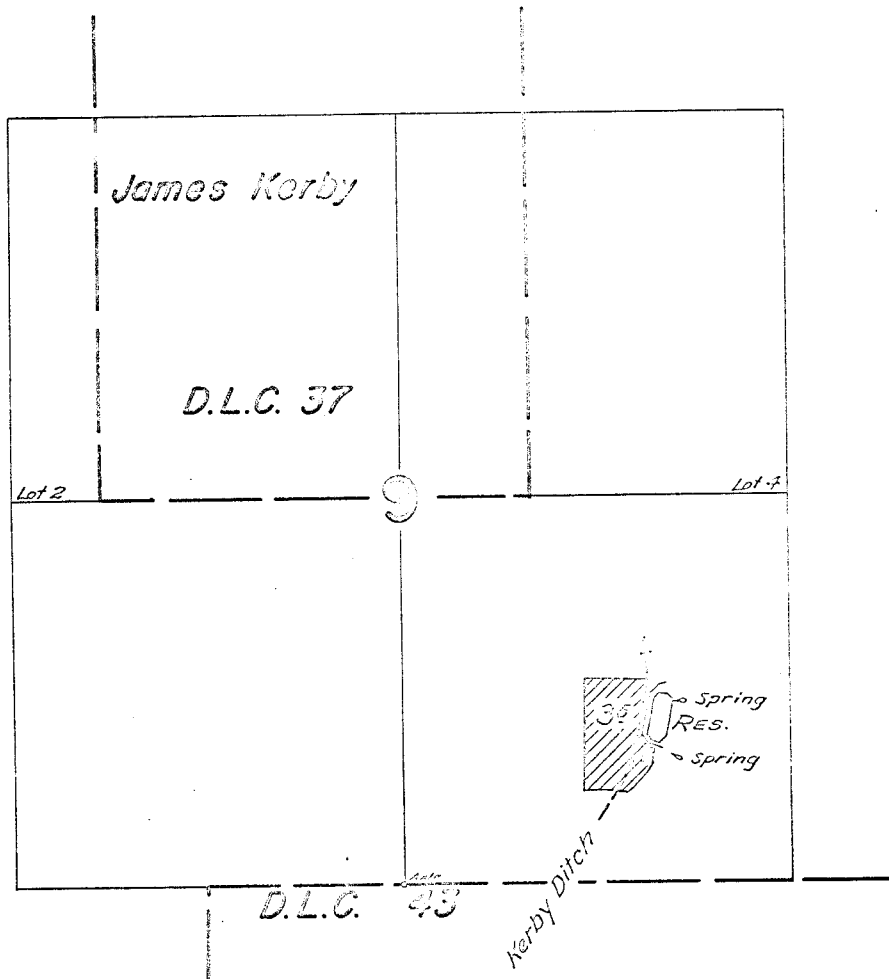

FINAL PROOF SURVEY UNDER

R-36400 R-2506
Application No. 36401 Permit No. 27107....
IN NAME OF

..... DALE CALL

Surveyed June 7, 1963, by *R. Johnson*