



34631
27204

12 7
13 18

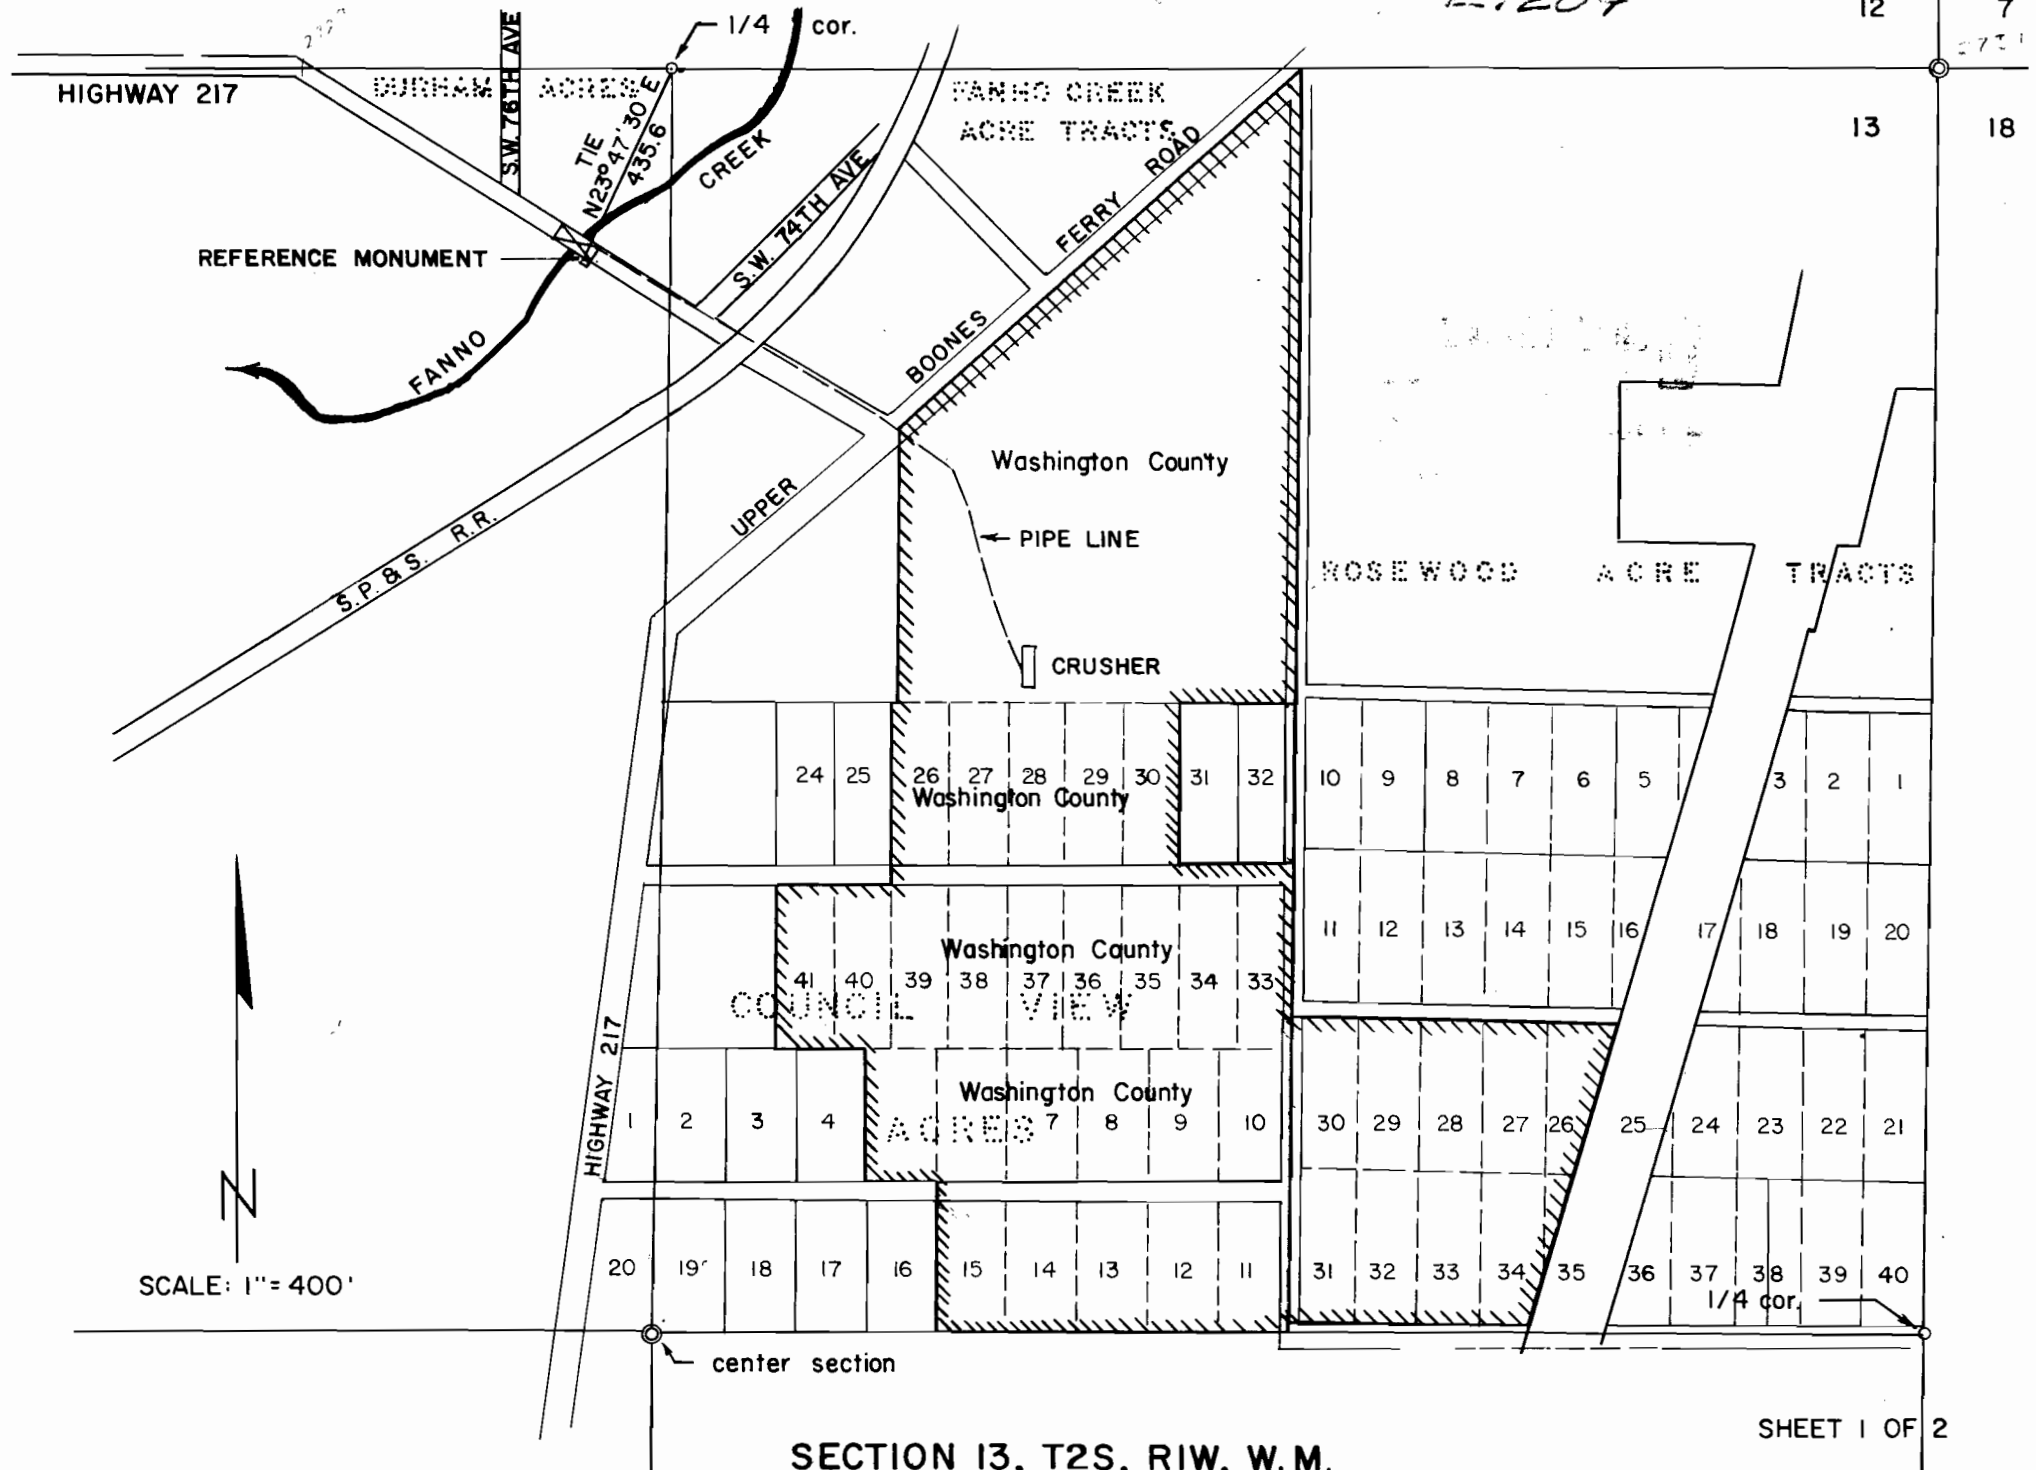

SECTION 13, T2S, RIW, W.M.

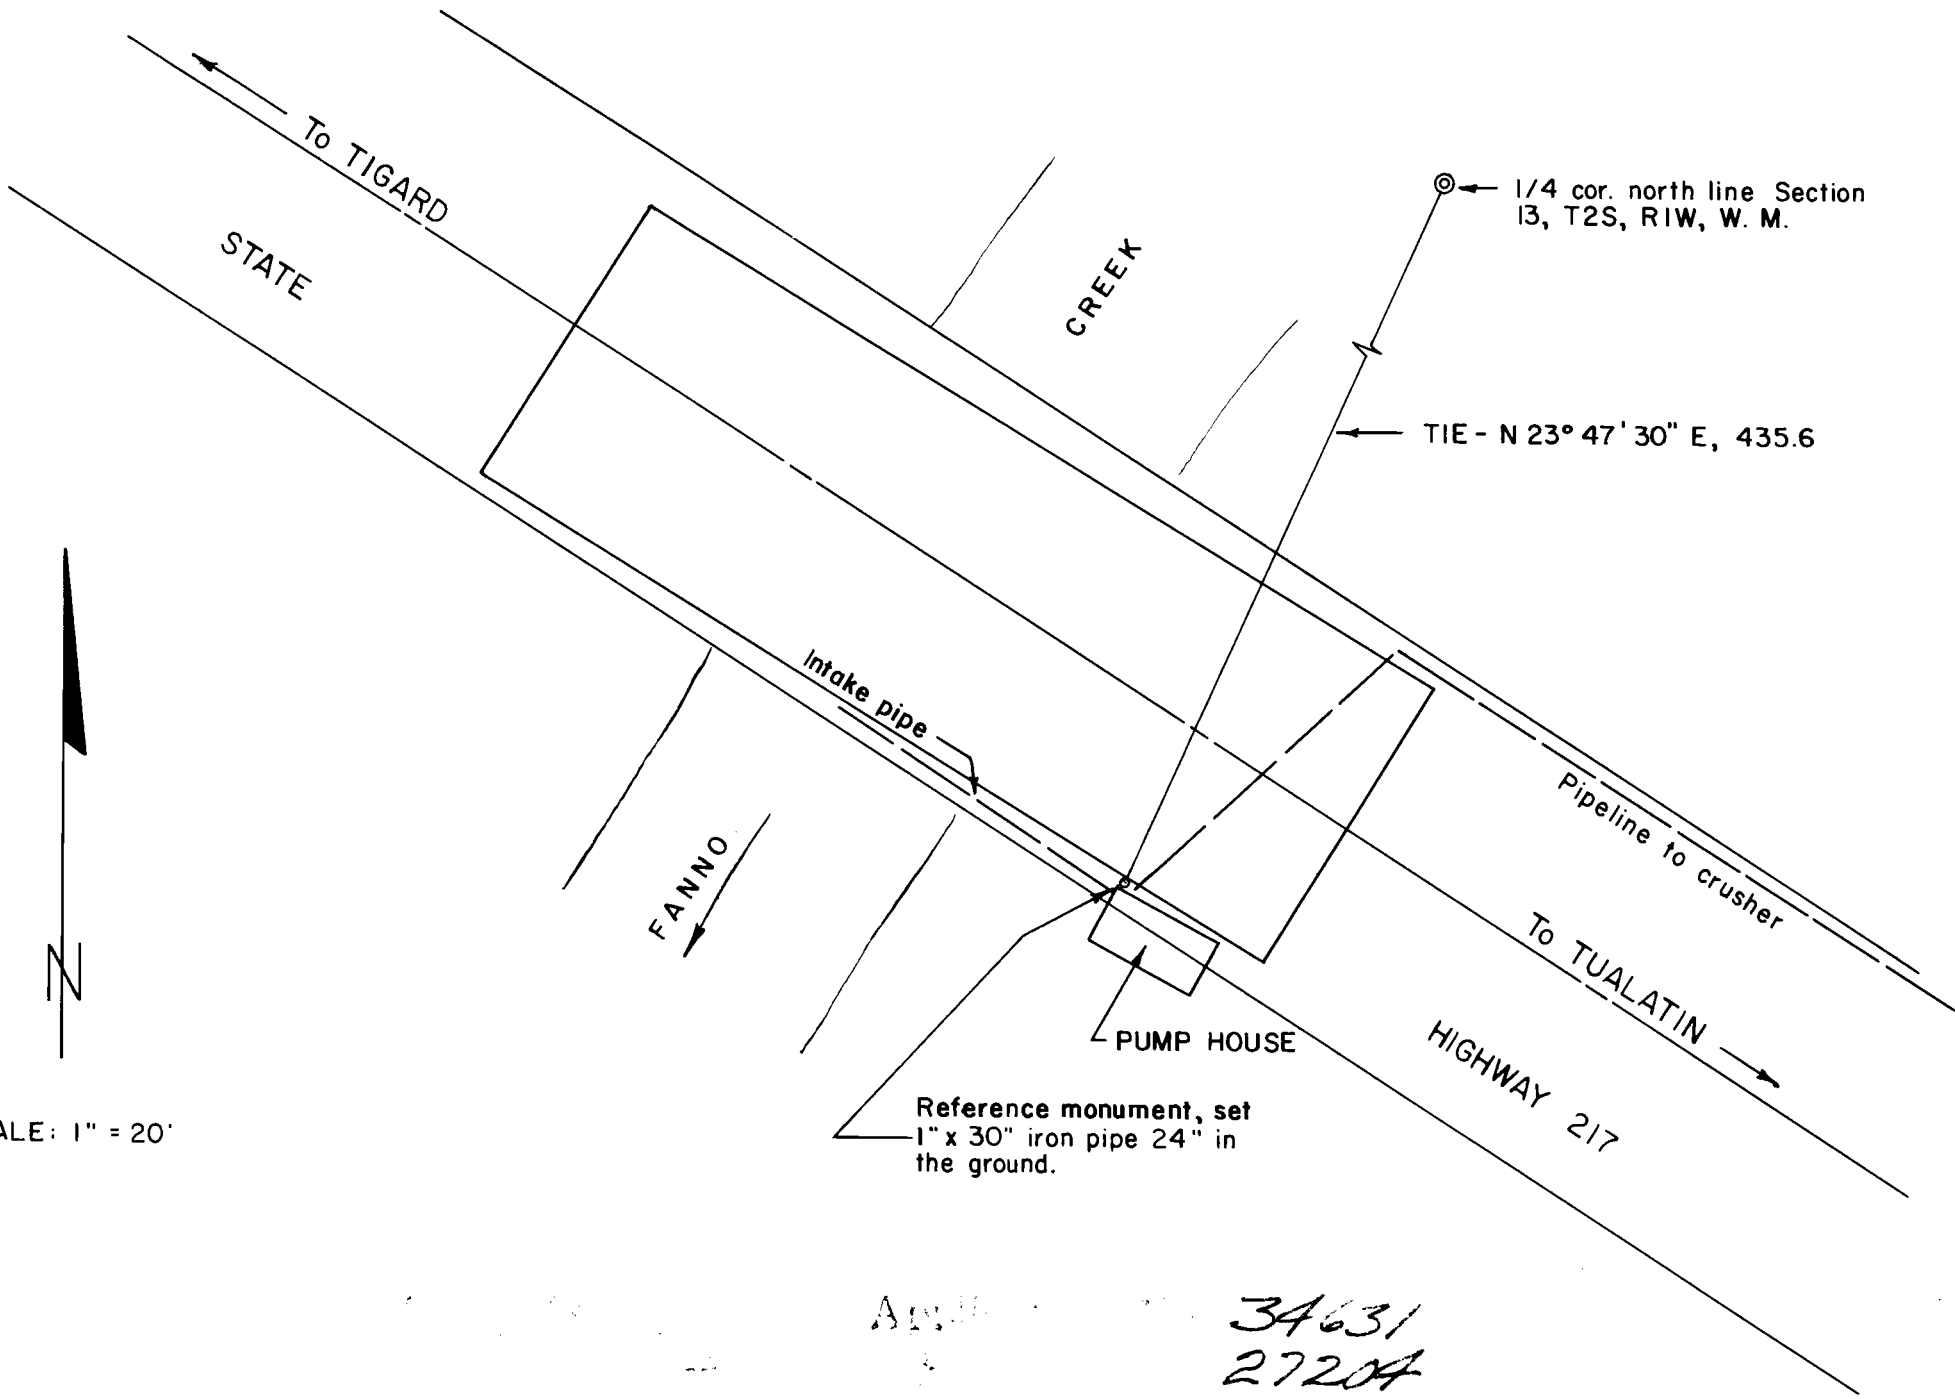

SCALE: 1" = 20'

34631
27204