


T.38S.R.5W.W.M.

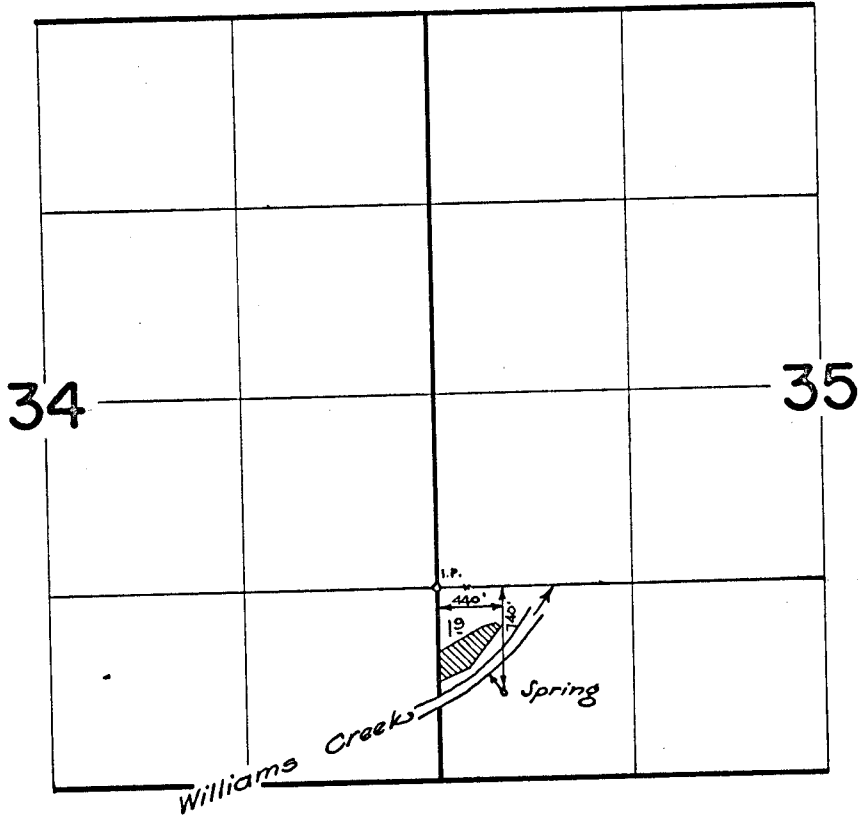

FINAL PROOF SURVEY UNDER

Application No. 34411..... Permit No. 27244.....
IN NAME OF

.....CLEO B. REEL.....

Surveyed June 24 1965, by *Al Jackson*