


T.13S. R.29E.W.M.

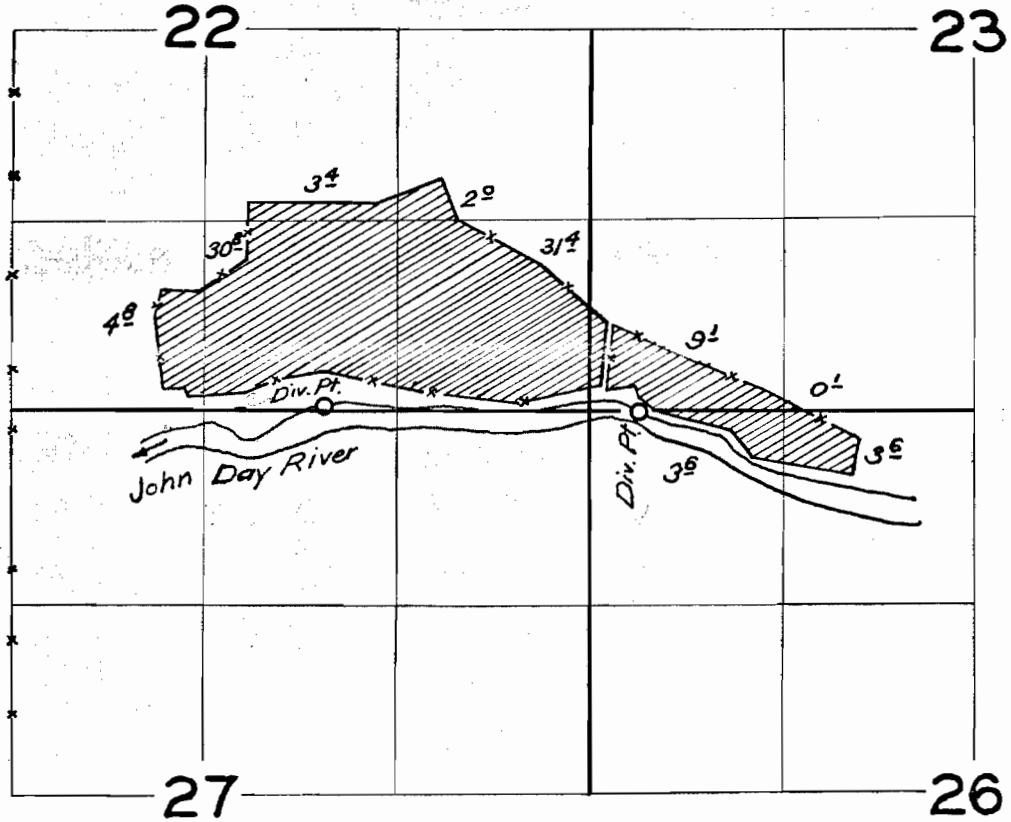

FINAL PROOF SURVEY
UNDER

Application No. *34754* Permit No. *27283*
IN NAME OF

Curtice Martin

ESTATE OF JOHN CAW RSE

Surveyed *Nov. 15* 1962, by *Ralph Jackson*