




VICINITY MAP Scale - 1"=2 Mile

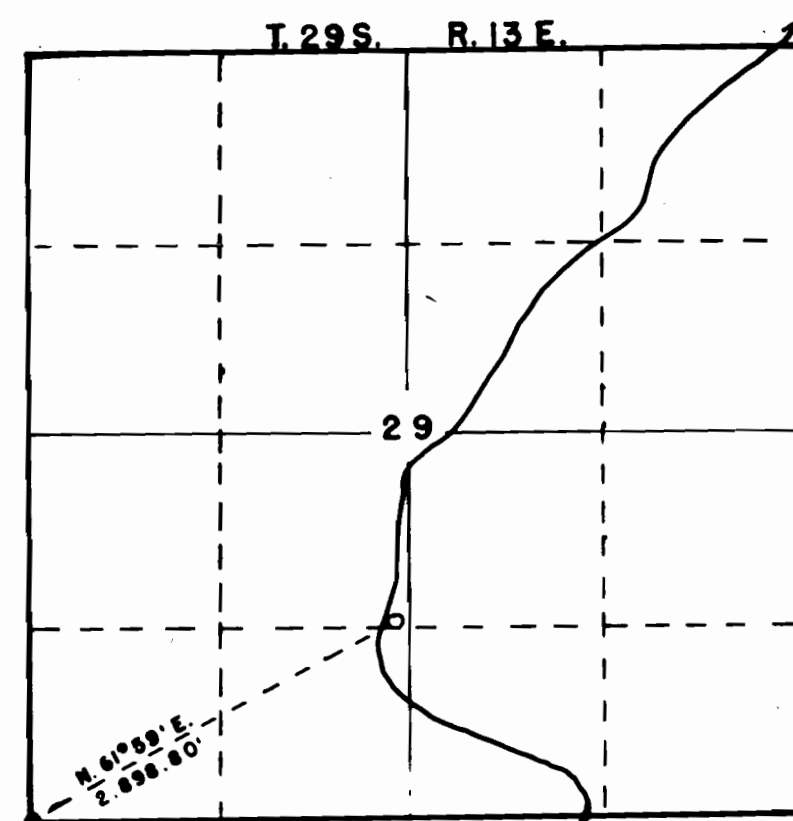


BRIDGE CREEK

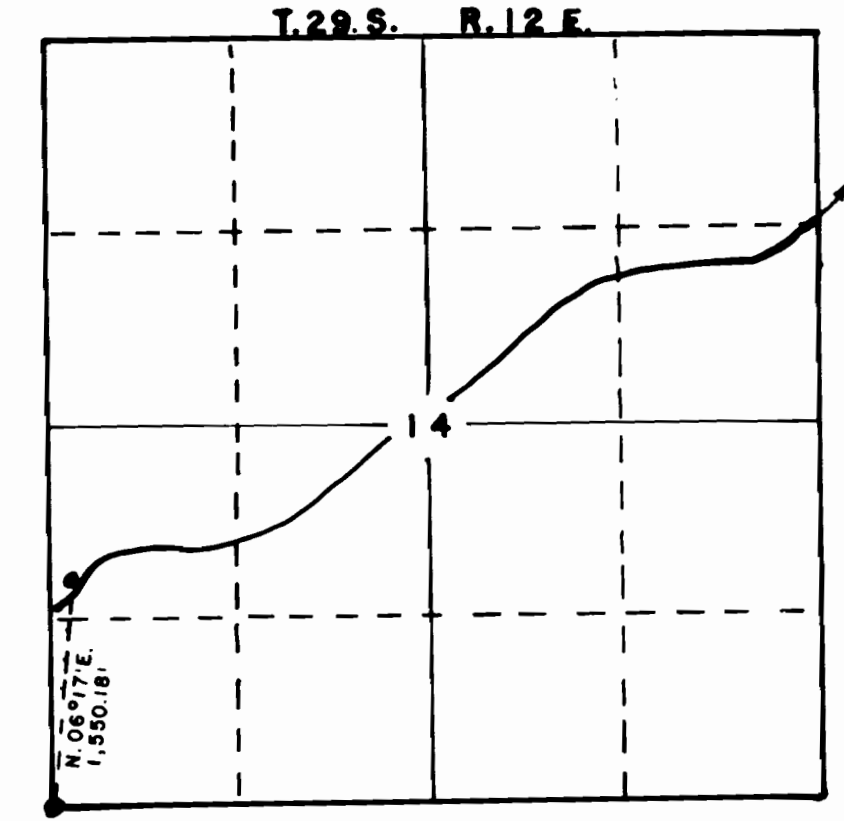

BUCK CREEK

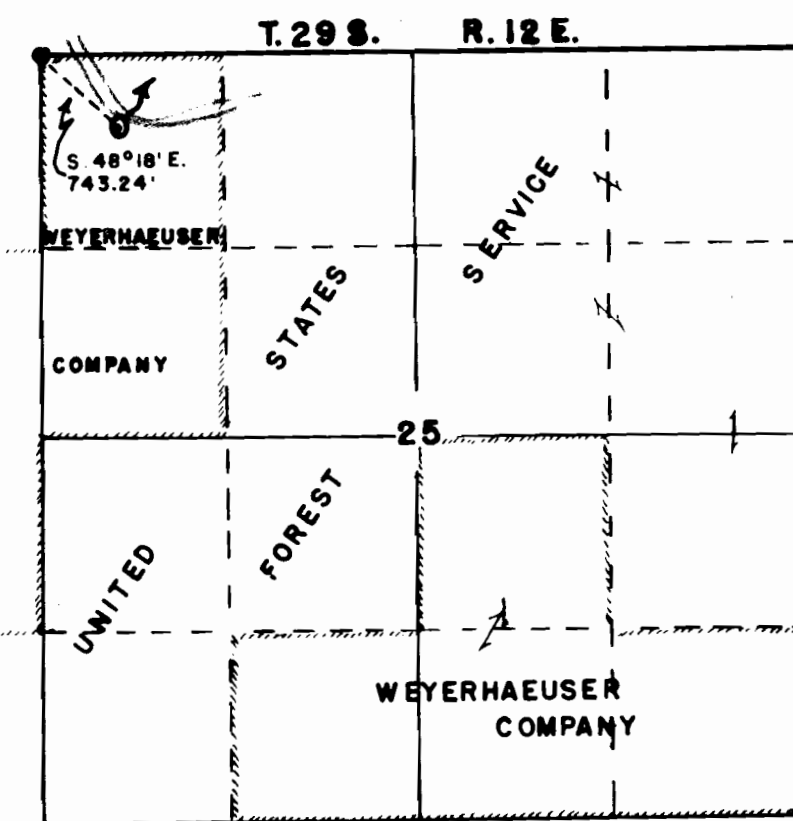


GOSHAW SPRING

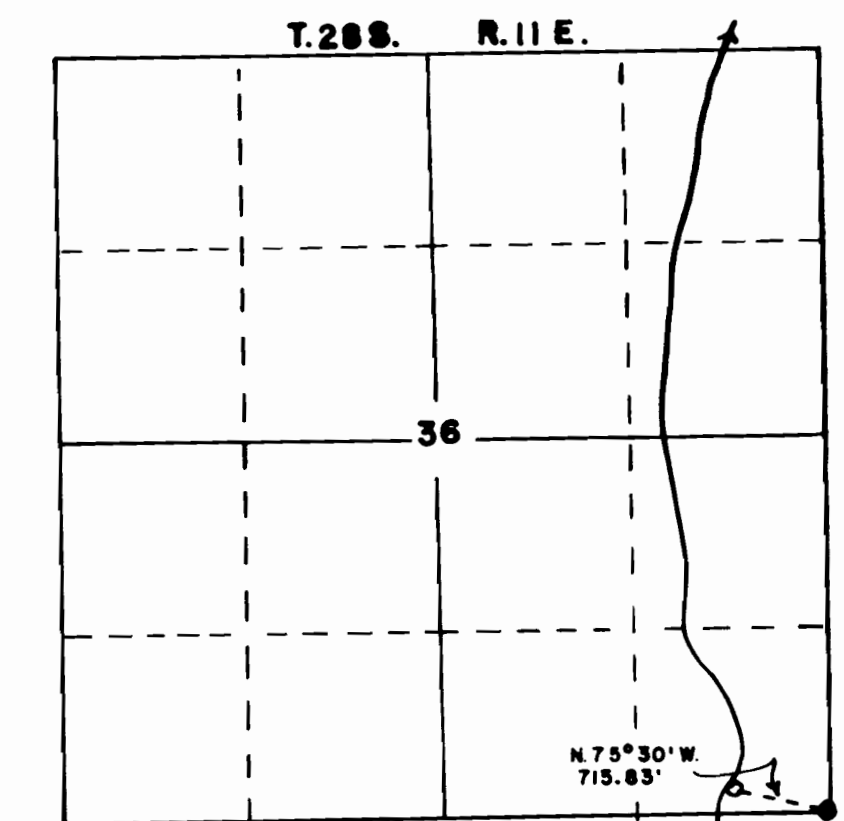


BEAR CREEK

Scale - 4"=1 Mile

34783  
27301

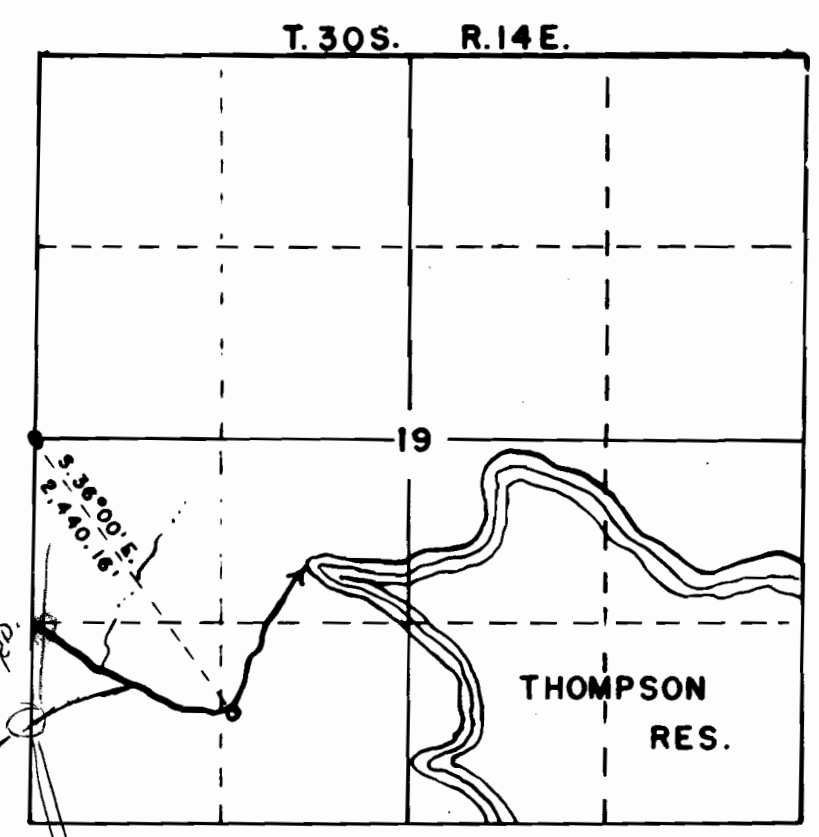

GUYER CREEK

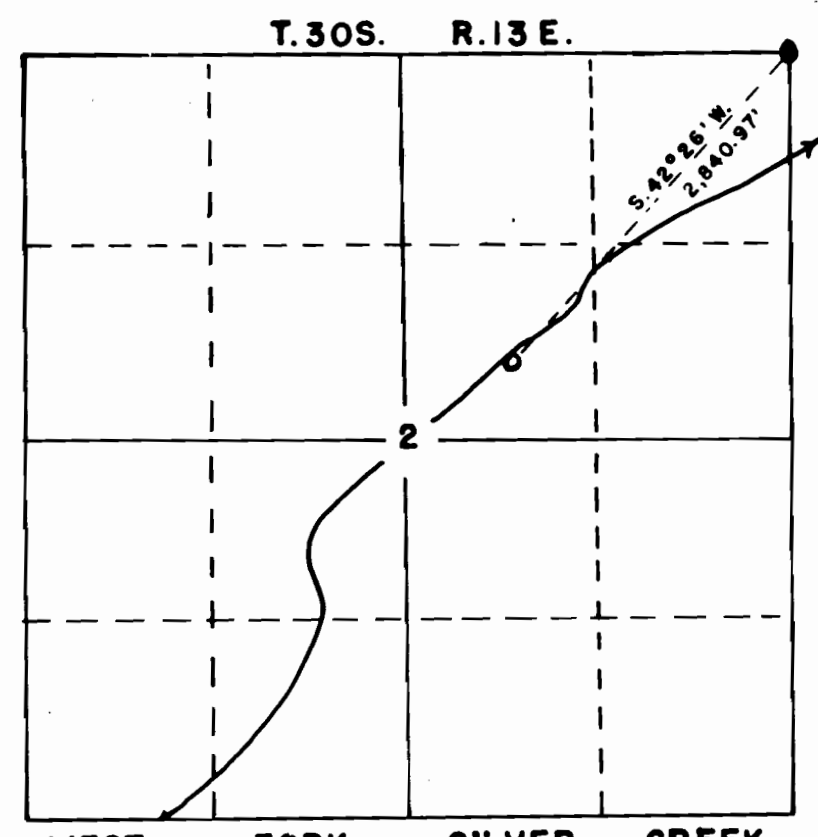

WEST FORK SILVER CREEK

Scale - 4"=1 Mile

I, G. M. UPINGTON OF WEYERHAEUSER COMPANY DO HEREBY CERTIFY THAT THIS MAP WAS MADE FROM NOTES TAKEN DURING AN ACTUAL SURVEY MADE UNDER MY IMMEDIATE SUPERVISION ON OCT. 13-14, 1961; THAT THE MONUMENTS SHOWN ON THIS MAP CONSISTING OF 1" X 36" IRON PIPES ARE 715.83 FT. N. 75° 30' W. OF SE SECTION CORNER SECTION 36, T. 28 S., R. 11 E.; 1550.16 FT. N. 06° 17' E. OF SW SECTION CORNER SECTION 14, T. 29 S., R. 12 E., W.M.; 743.24 FT. S. 48° 18' E. OF NW SECTION CORNER SECTION 25, T. 29 S., R. 12 E., W.M.; 2,898.80 FT. N. 61° 59' E. OF SW SECTION CORNER SECTION 29, T. 29 S., R. 13 E., W.M.; 2,840.97 FT. S. 42° 26' W. OF NE SECTION CORNER SECTION 2, T. 30 S., R. 13 E., W.M.; 2,440.16 FT. S. 36° 00' E. OF W 1/4 CORNER SECTION 19, T. 30 S., R. 14 E., W.M..



|  |                        |
|--|------------------------|
| WATER RIGHTS APPLICATION                           |                        |
| SECS. 2, 14, 19, 25, 29, 36                        |                        |
| Ts. 28, 29, & 30 S., Rs. 11, 12, 13, & 14 E., W.M. |                        |
| WEYERHAEUSER COMPANY                               |                        |
| LUMBER & PLYWOOD DIVISION                          |                        |
| KLAMATH FALLS BRANCH                               |                        |
| SCALE - AS SHOWN                                   | DATE - MAR. 3, 1961    |
| DEL. - C.L.C.                                      | CHECKED BY - <i>EM</i> |
| TRACED - C.L.C.                                    | DRAWING No - K203-5    |

C-4-17

10-18-77, R.G.M.  
DIV HERE FROM DIFFERENT MAP OF APPLICANT  
GUYER CR.