


TWP 33 S R5WWM

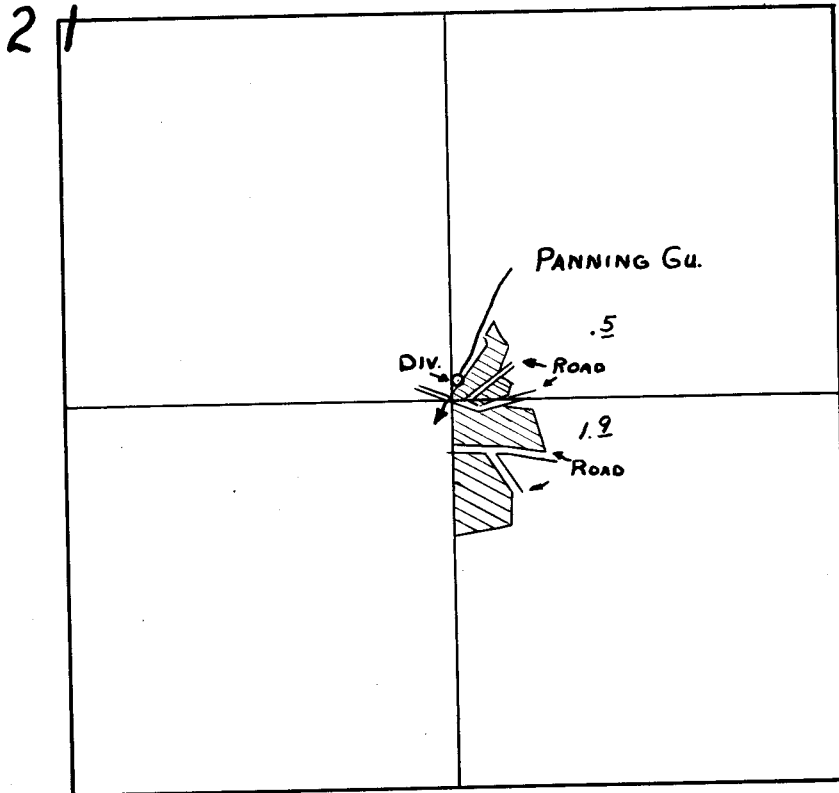

SE  $\frac{1}{4}$  SEC 21

SCALE 1" = 660'

**FINAL PROOF SURVEY**  
UNDER

Application No. **34953** Permit No. **27412**  
IN NAME OF

**HENRY AND IDA I. HERMAN**

Surveyed **6-14** 19**63**, by **R STEIMER**