


TWP 36 S R 7 W W M

NW 1/4 Sec. 14

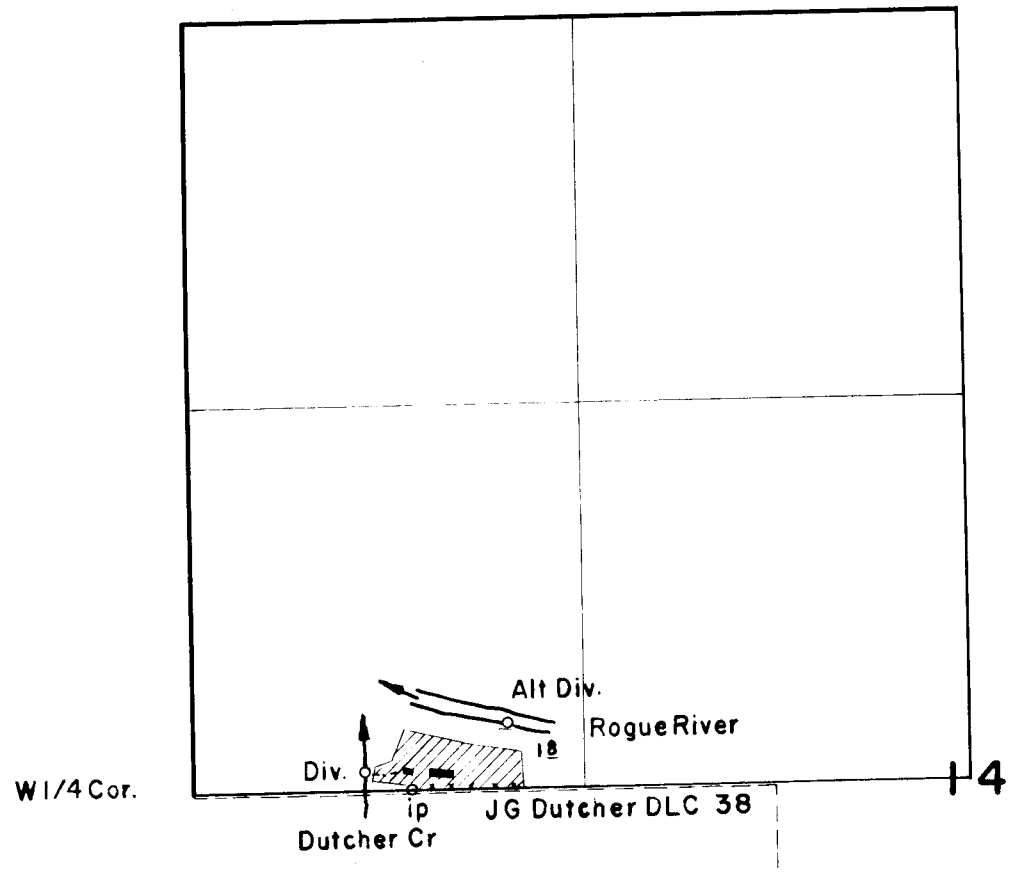

FINAL PROOF SURVEY
UNDER

Application No. 34972 Permit No. 27427
IN NAME OF

EB or Evelyn E Bennett

Surveyed 6-4 1962, by R Steimer
Scale 8" = 1 Mi