


RECEIVED

T-5547

OCT 8 1984

WATER RESOURCES DEPT
SALEM, OREGON

T.32S. R.5W. W.M.

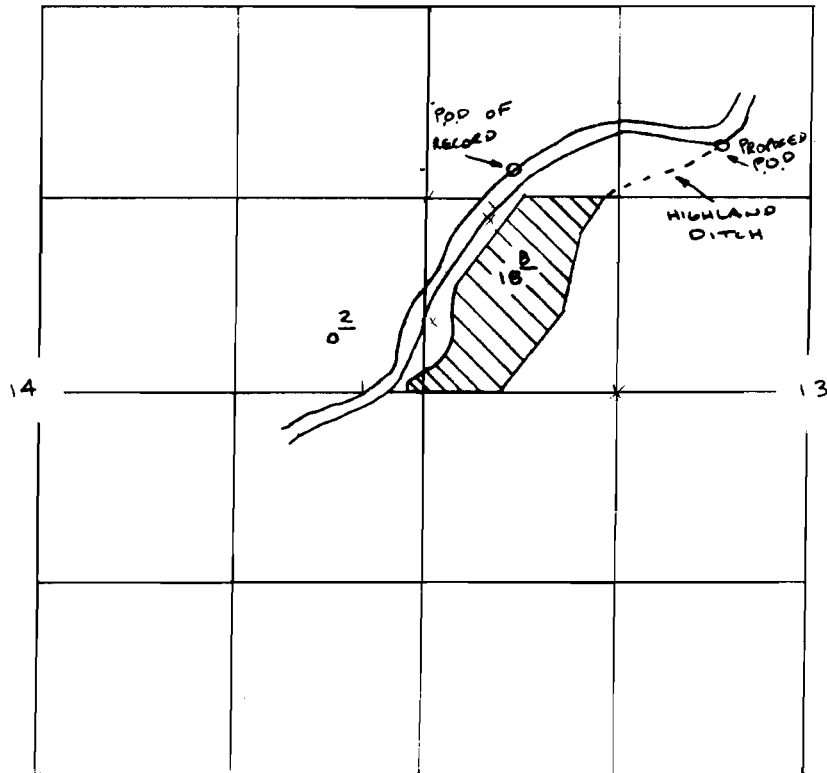

"
4 = 1 MILE

 = PERMIT # 27431

POD OF RECORD = 1120' S. $\frac{1}{2}$ 610' E. NW COR. S. 13

PROPOSED POD = 915 S. $\frac{1}{2}$ 490' W. N $\frac{1}{4}$ S. 13