

HURLEY'S FRUIT LAND SUBDIVISIONS


& ADJOINING PLATS

In the South half of the John Hess D.L.C.; Not. 1419, Claim 39

In Sections 18, 19, T3S, R2W & Sections 13, 24, T3S, R3W.

ALL TAX LOT NUMBERS ARE 1932 UNLESS OTHERWISE MARKED


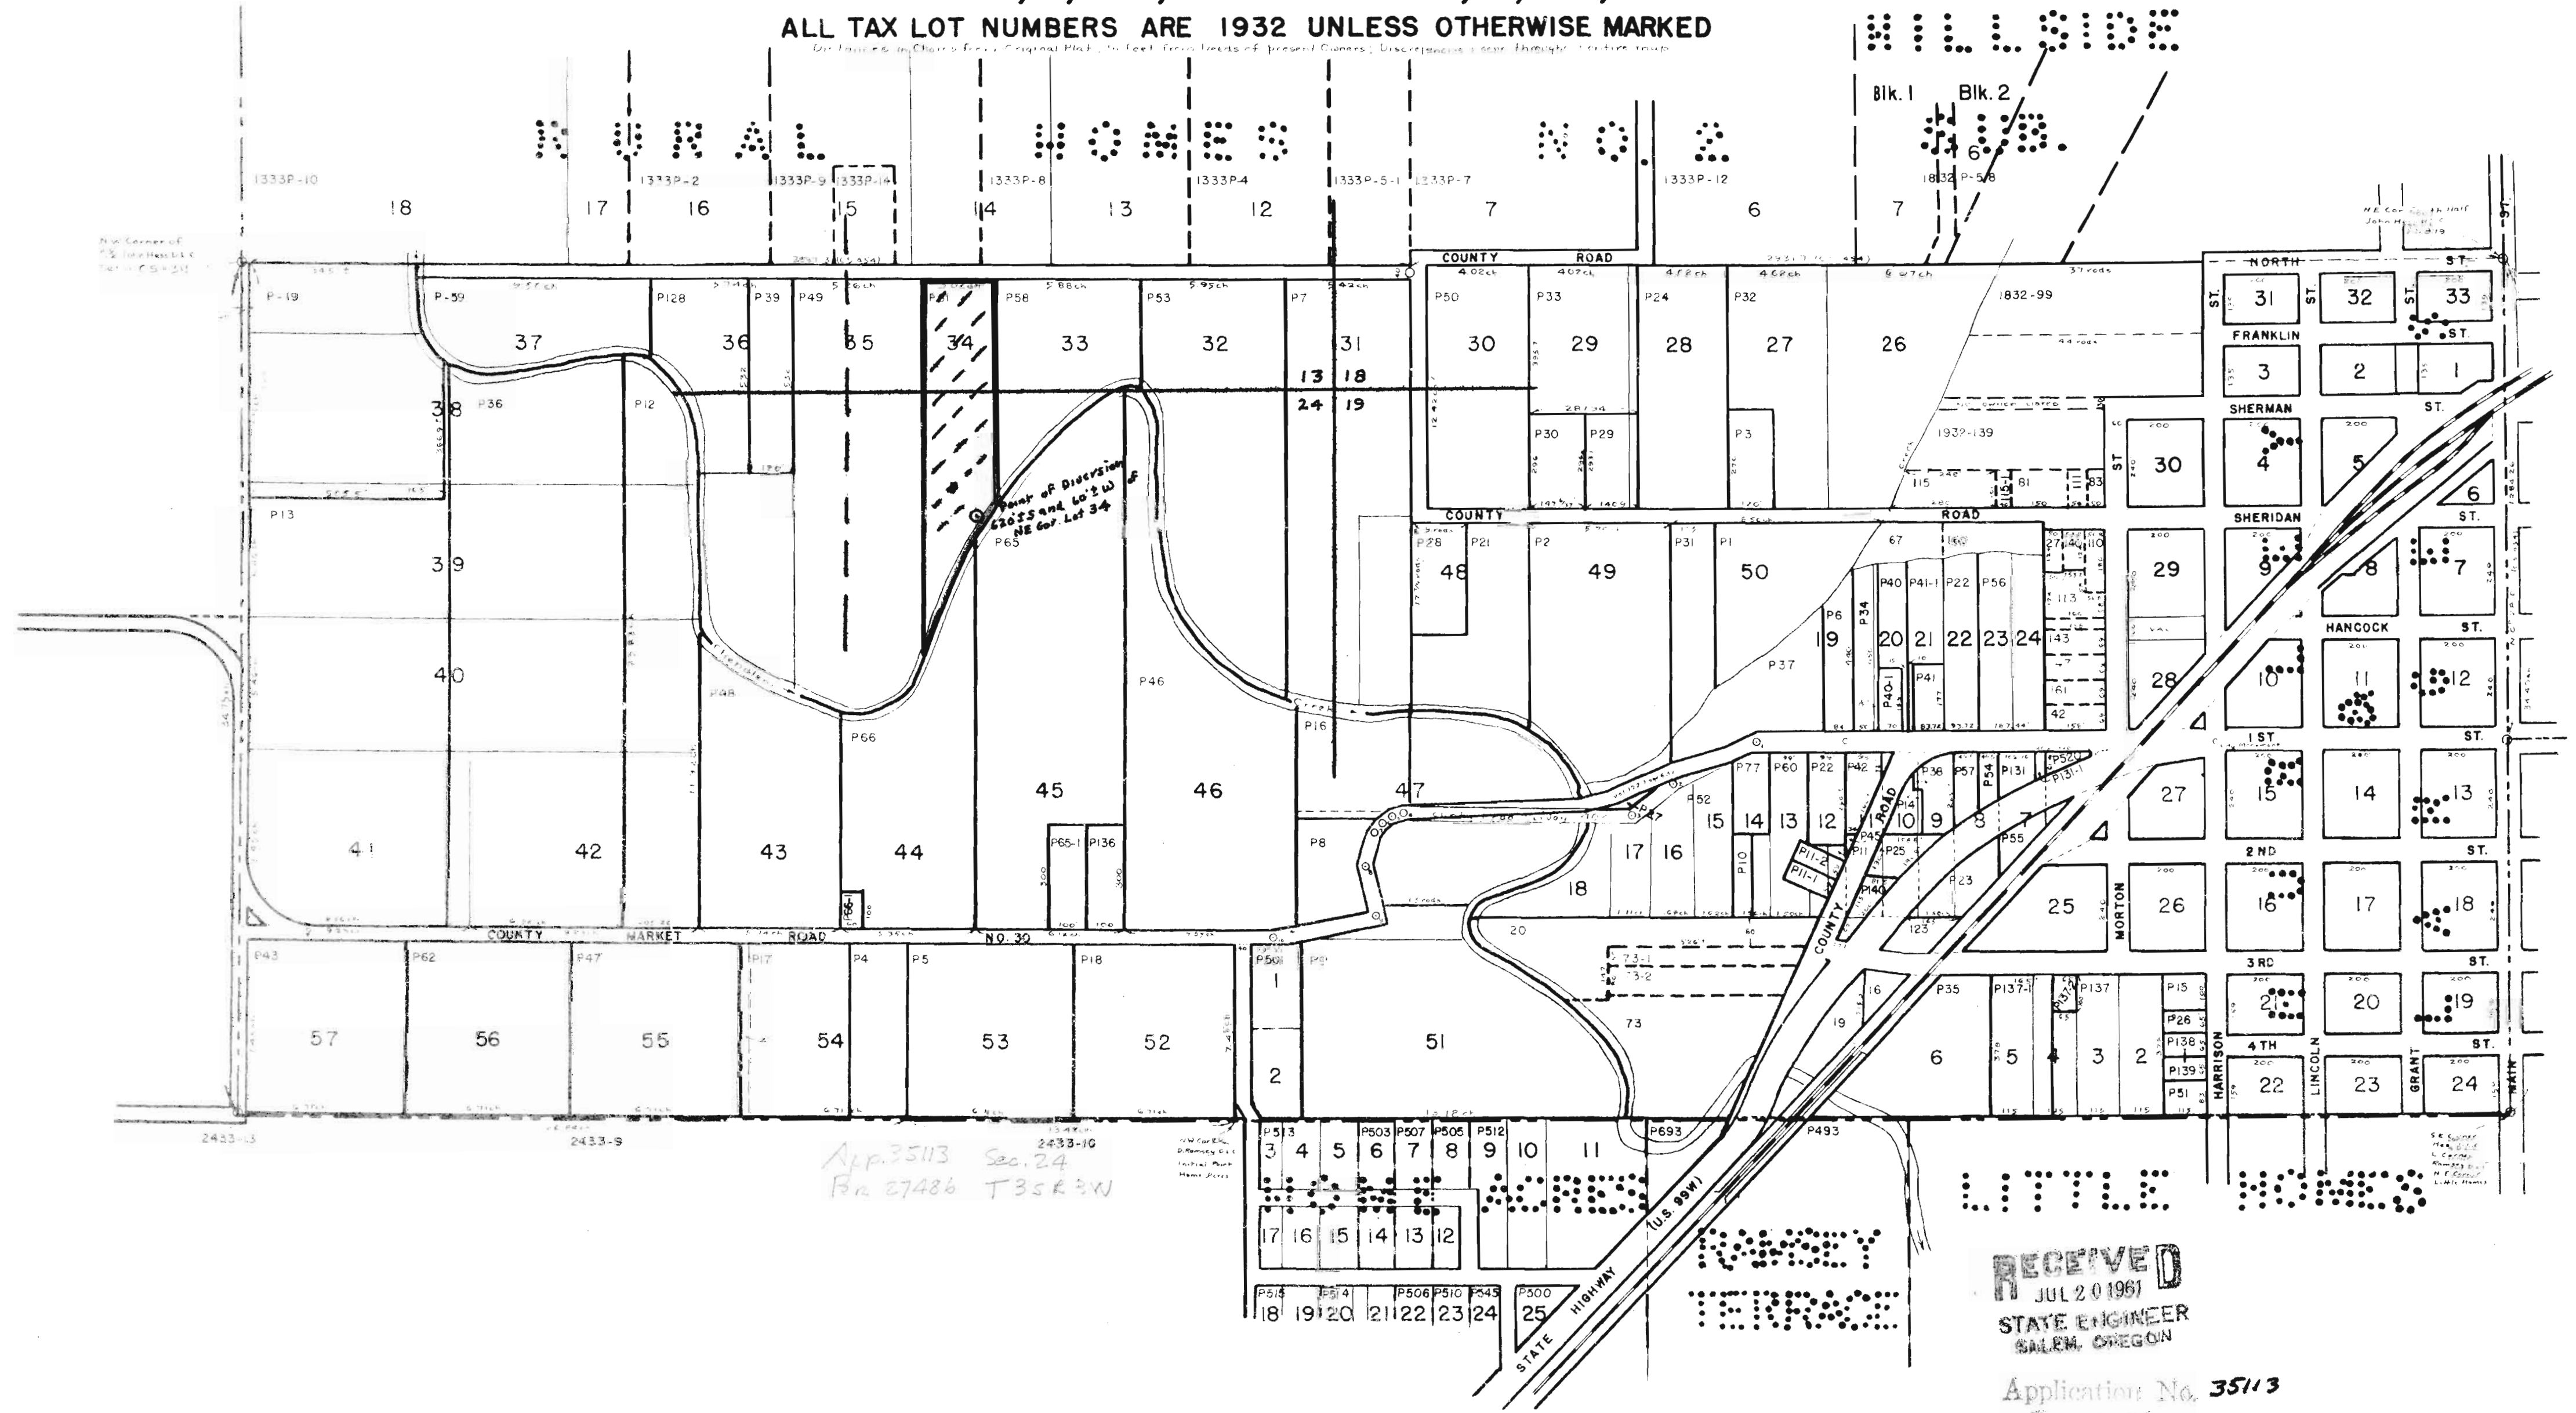

App. 35113 Sec. 24

RECEIVED
JUL 20 1961
STATE ENGINEER
SALEM, OREGON

Application No. 35113
Permit No. 27486